


Prepared for
~ Mr. Winters ~

Scale 1" = 100' Sept. 1955

COUNTY SURVEYORS FILE DAT
DO NOT REMOVE FROM OFFICE

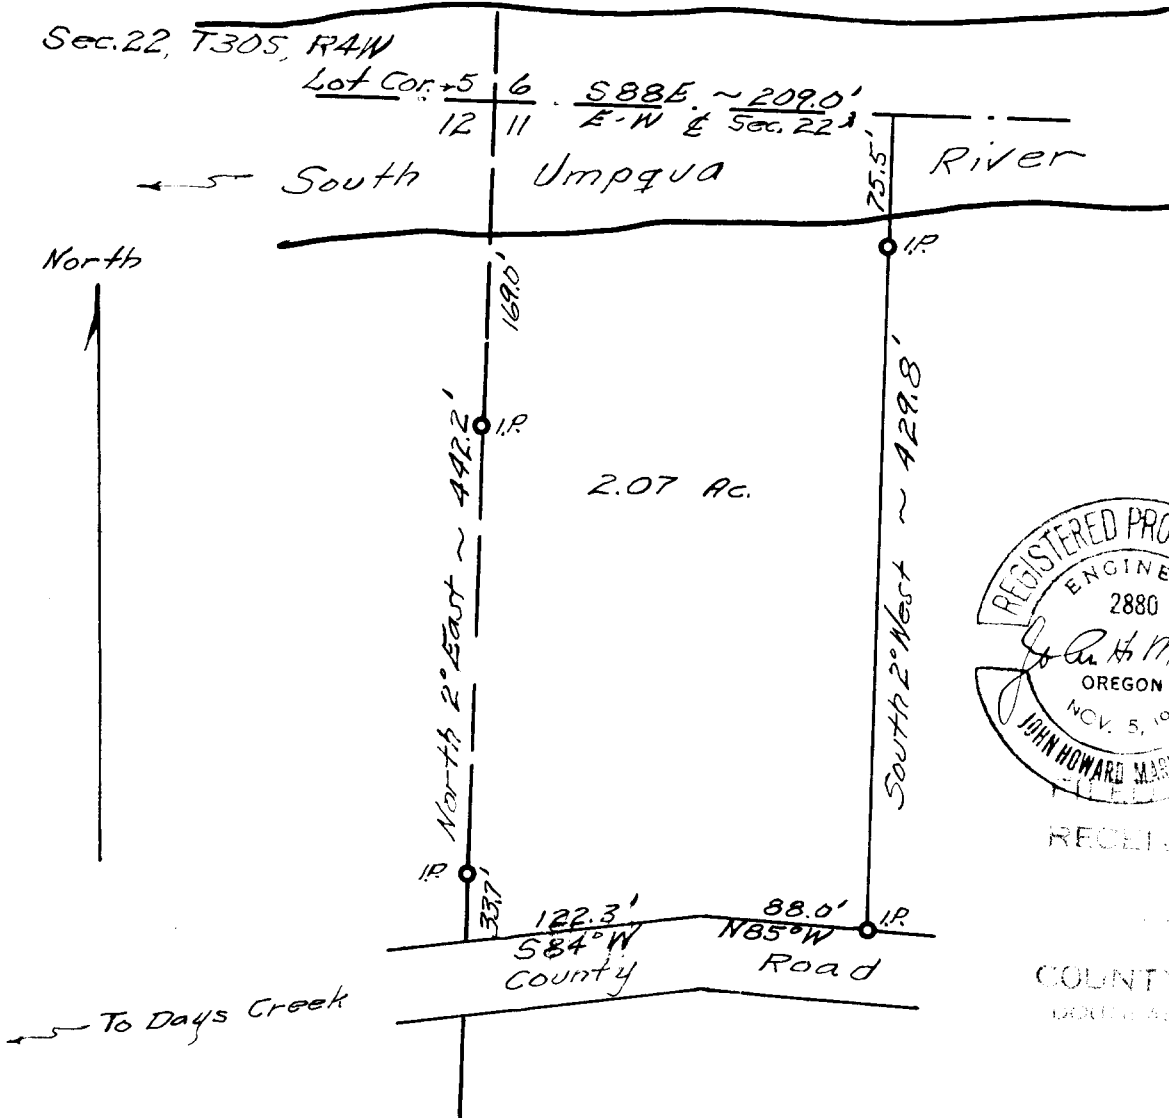

RECEIVED

COUNTY SURVEYOR
DADE COUNTY, OREGON

T30-S.22

C. S. File No. 51/131-8