

Prepared for

FILED
RECEIVED

~ D. F. Powell ~

showing

Lot + Improvements in Sec. 30, T30S, R5W, W.M. Oregon

COUNTY SURVEYOR Scale 1"=50' March 1956
DOUGLAS COUNTY


I hereby certify that I have correctly surveyed the above described property and that the improvements shown and described hereon are within the property lines.

John H. Markham, Jr.

COUNTY SURVEYOR'S FILE DATA
DO NOT REMOVE FROM OFFICE

← To Riddle

County Road To Canyonville →

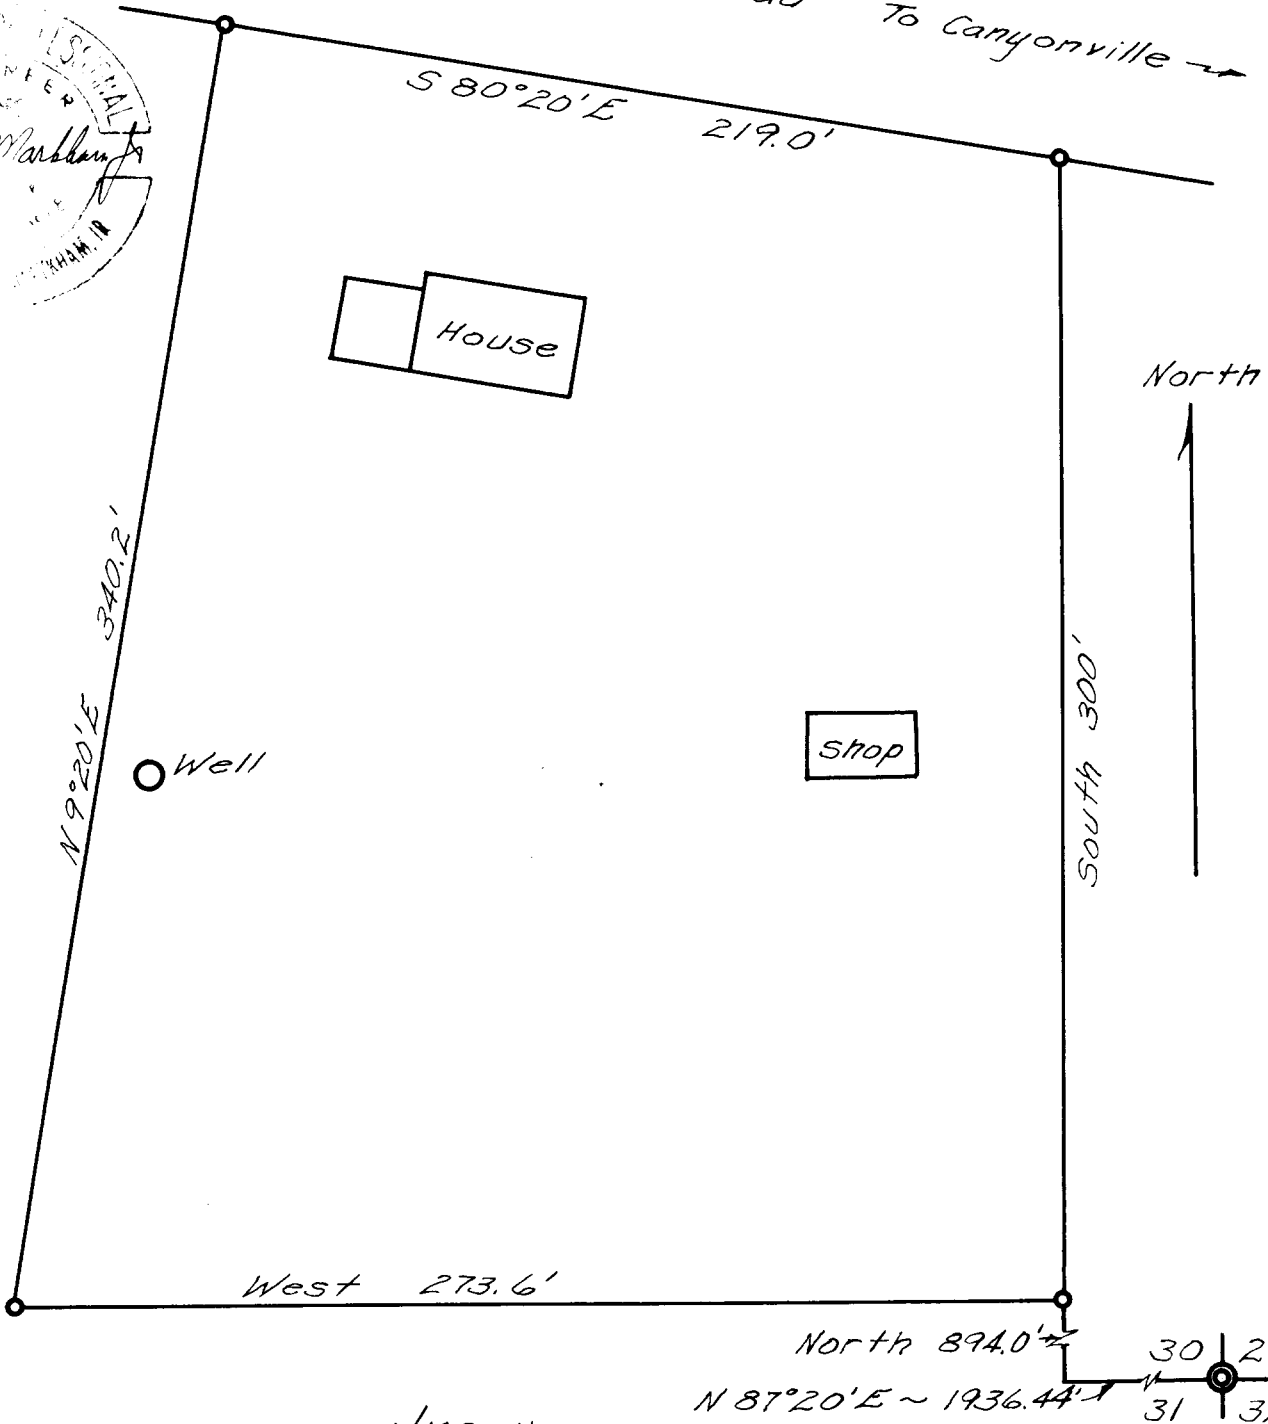

51/132-11