




Prepared for
 R. T. ZENOR
 Portion of Sec. 30, T30S, R5W, W.M.
 Scale 1" = 100' May 1951

COUNTY SURVEYORS FILE DATA
REGISTRY

John H. Marble
 SURVEYOR
 OREGON

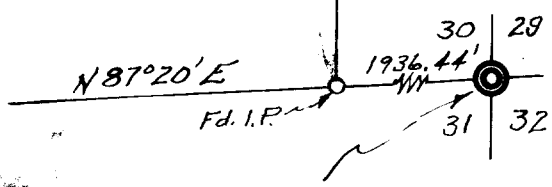

S.E. Corner Sec. 30
 T30S, R5W, W.M.