

COUNTY SURVEYORS FILE DATA  
DO NOT REMOVE FROM OFFICE

PREPARED FOR

ROBERT E. PROCTOR



PORTION OF SEC. 32 T30S. R5W. W.M.

SCALE 1"=100'

APRIL 1949

FILED  
APR 19 1949

COUNTY SURVEYORS  
OFFICE

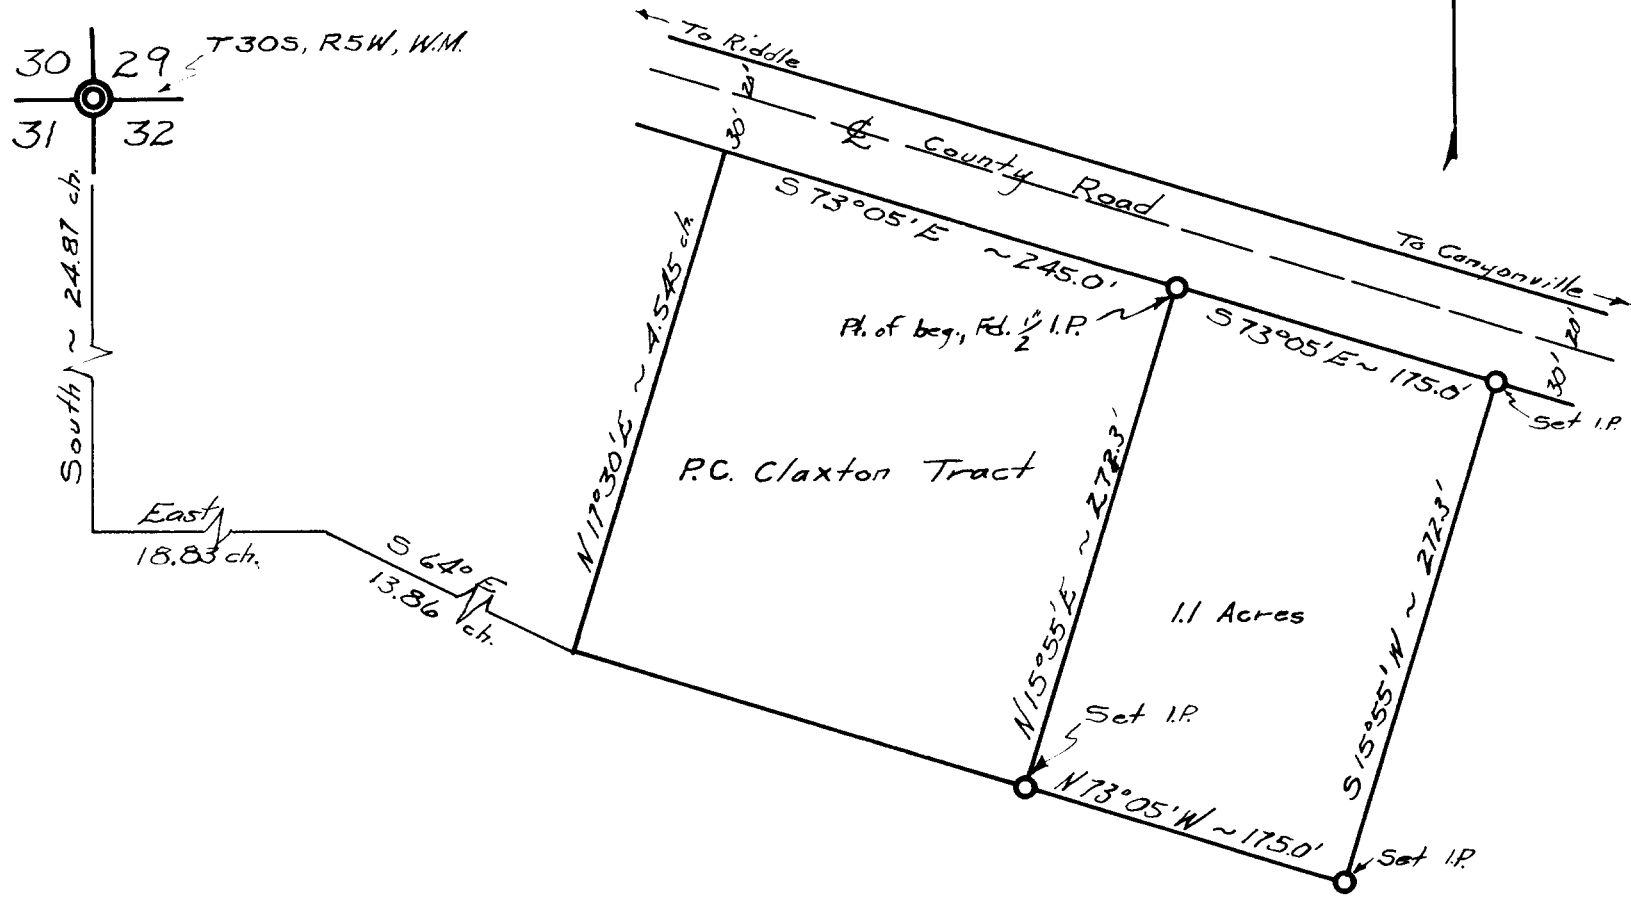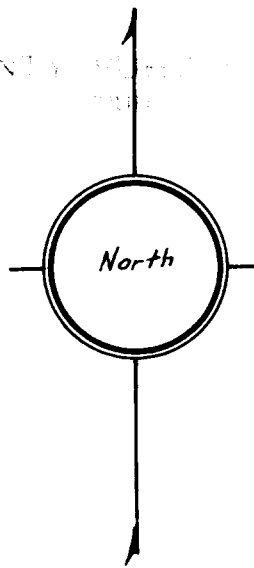

U.S. File No. 51/134-1