

COUNTY SURVEYORS FILE DATA
DO NOT REMOVE FROM OFFICE

19

PREPARED FOR

NORMAN OLSEN

PORTION OF SEC. 25 T30S R6W

SCALE 1" = 50' MAY 1949

1.37 Ac.

0.50 Acres


Norman Olsen Tract

0.64 Acres

Ernest Zimmerman Tract



John H. Marshall

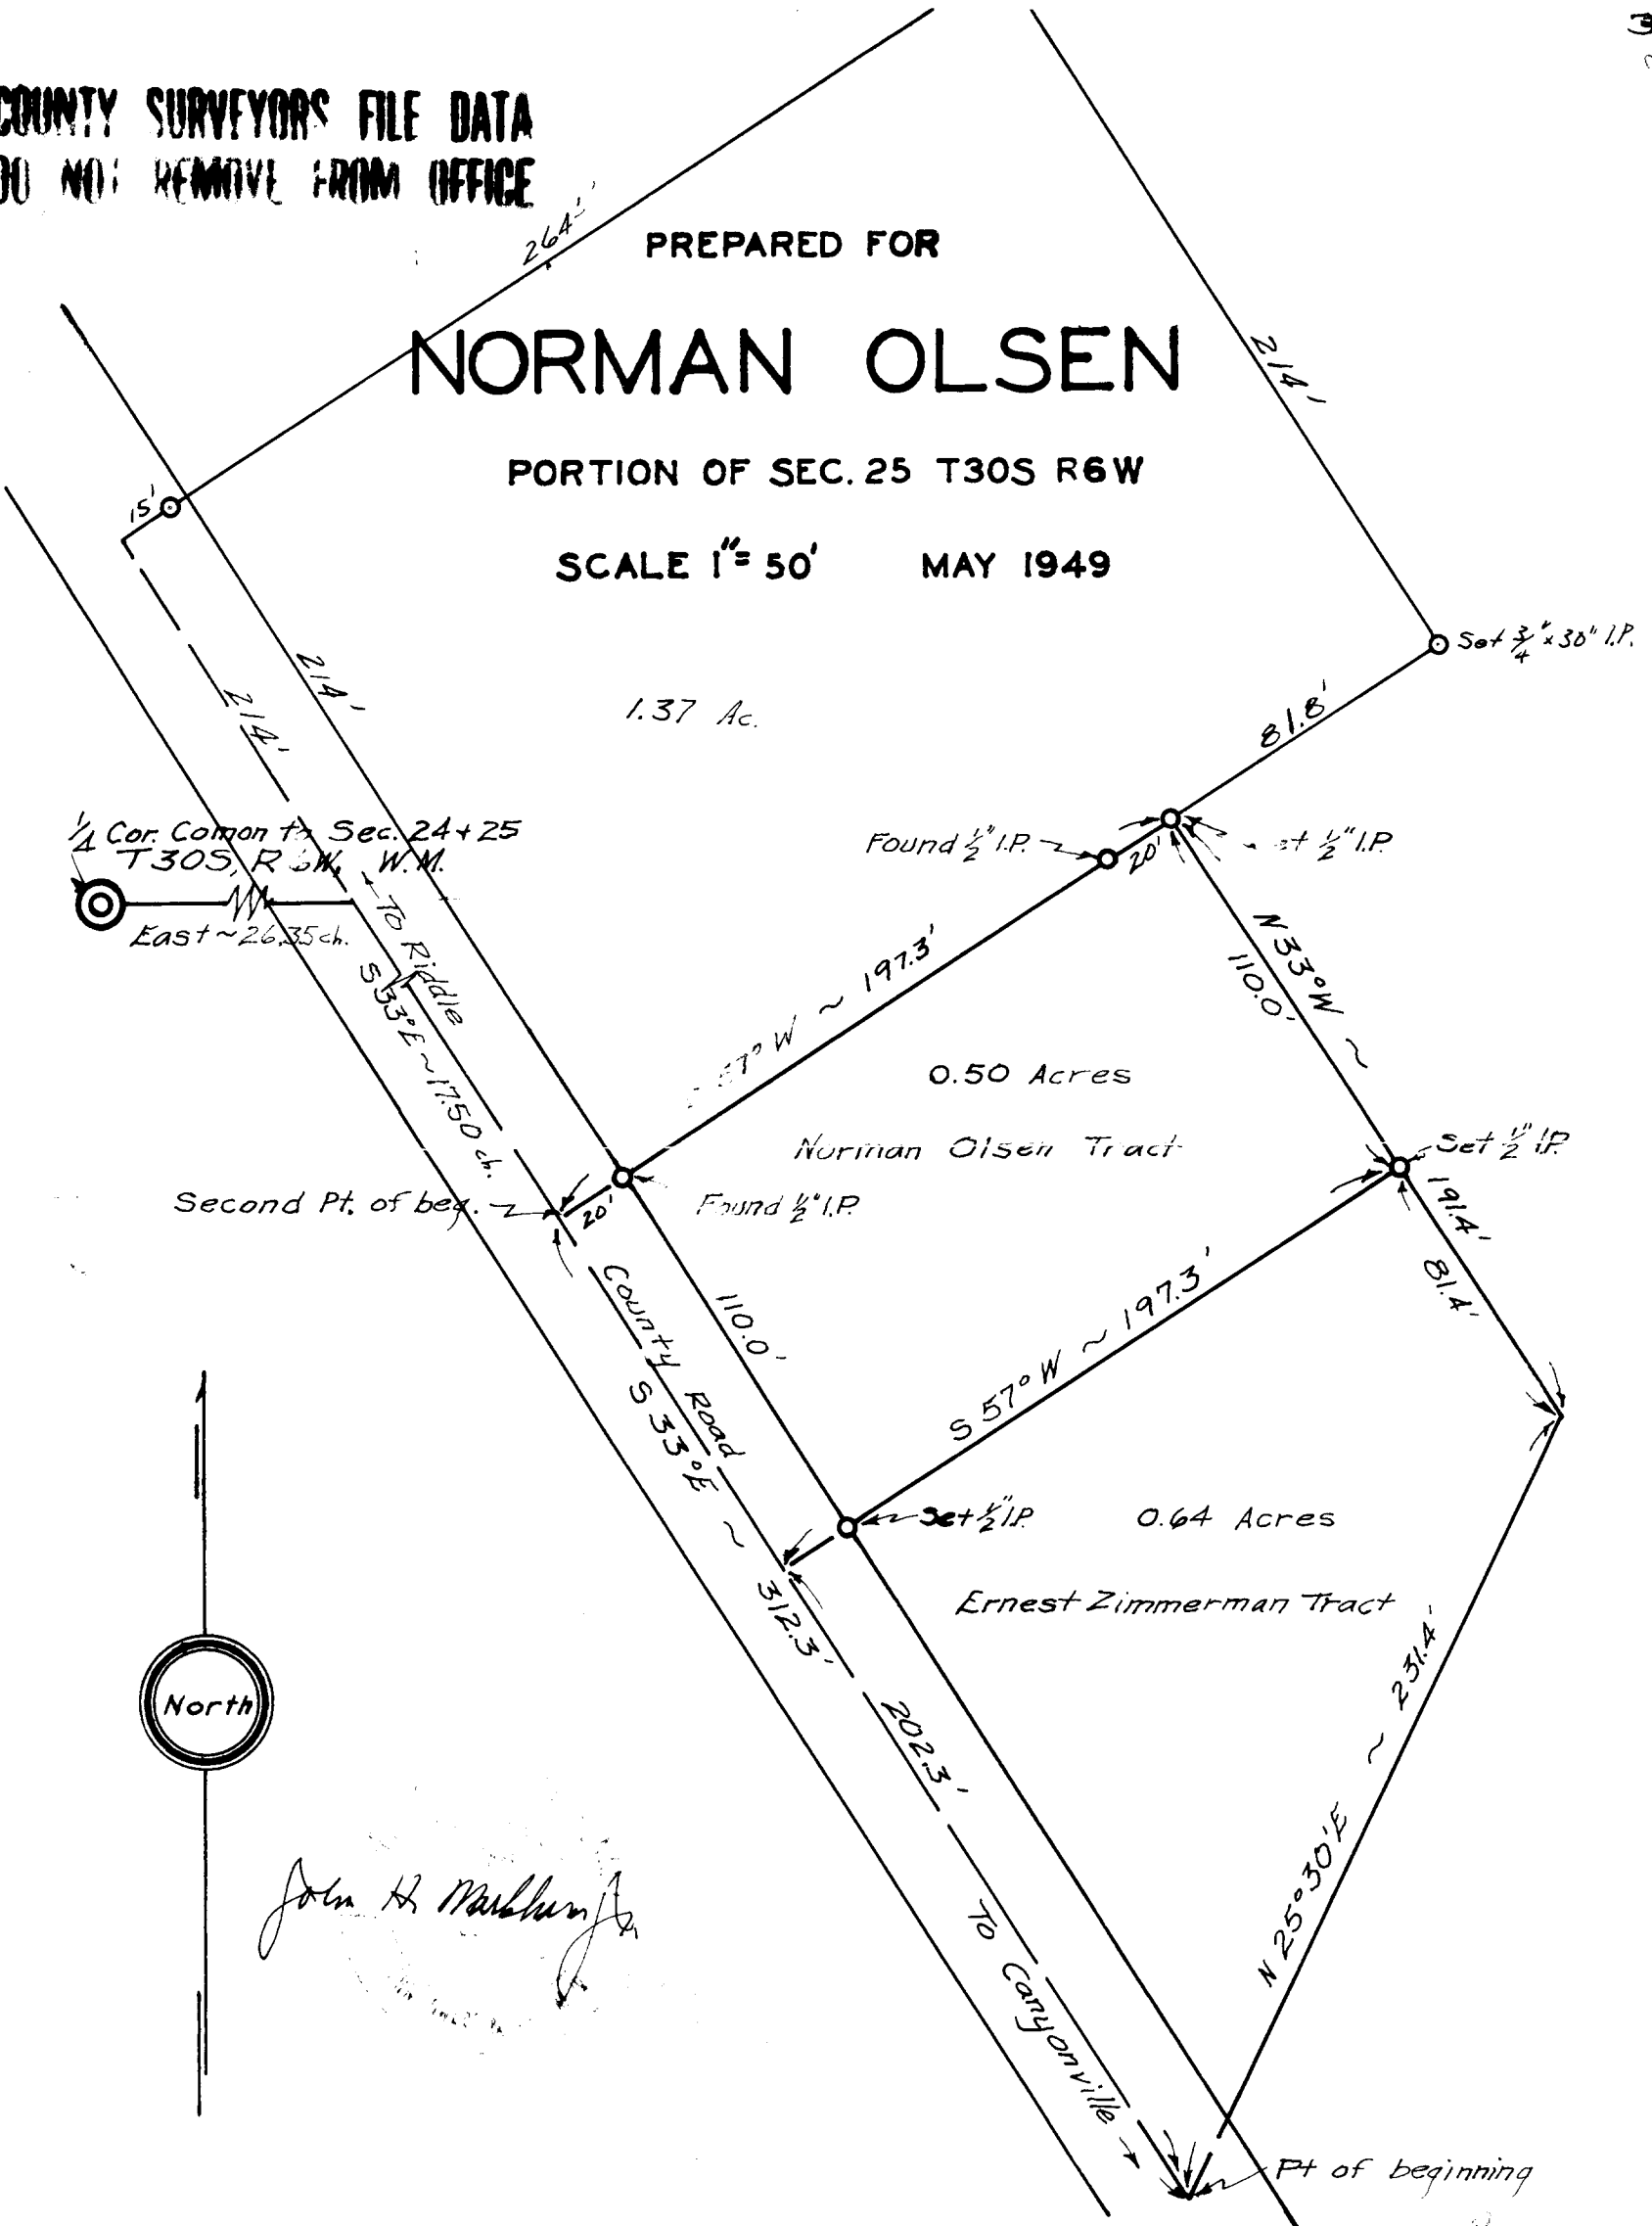

51/136-3