


COUNTY SURVEYORS FILE DATA
DO NOT REMOVE FROM OFFICE

Prepared for

FRED LEAKE

Portion of Sec. 25, T305, R6W.

Scale 1" = 100' June 1950

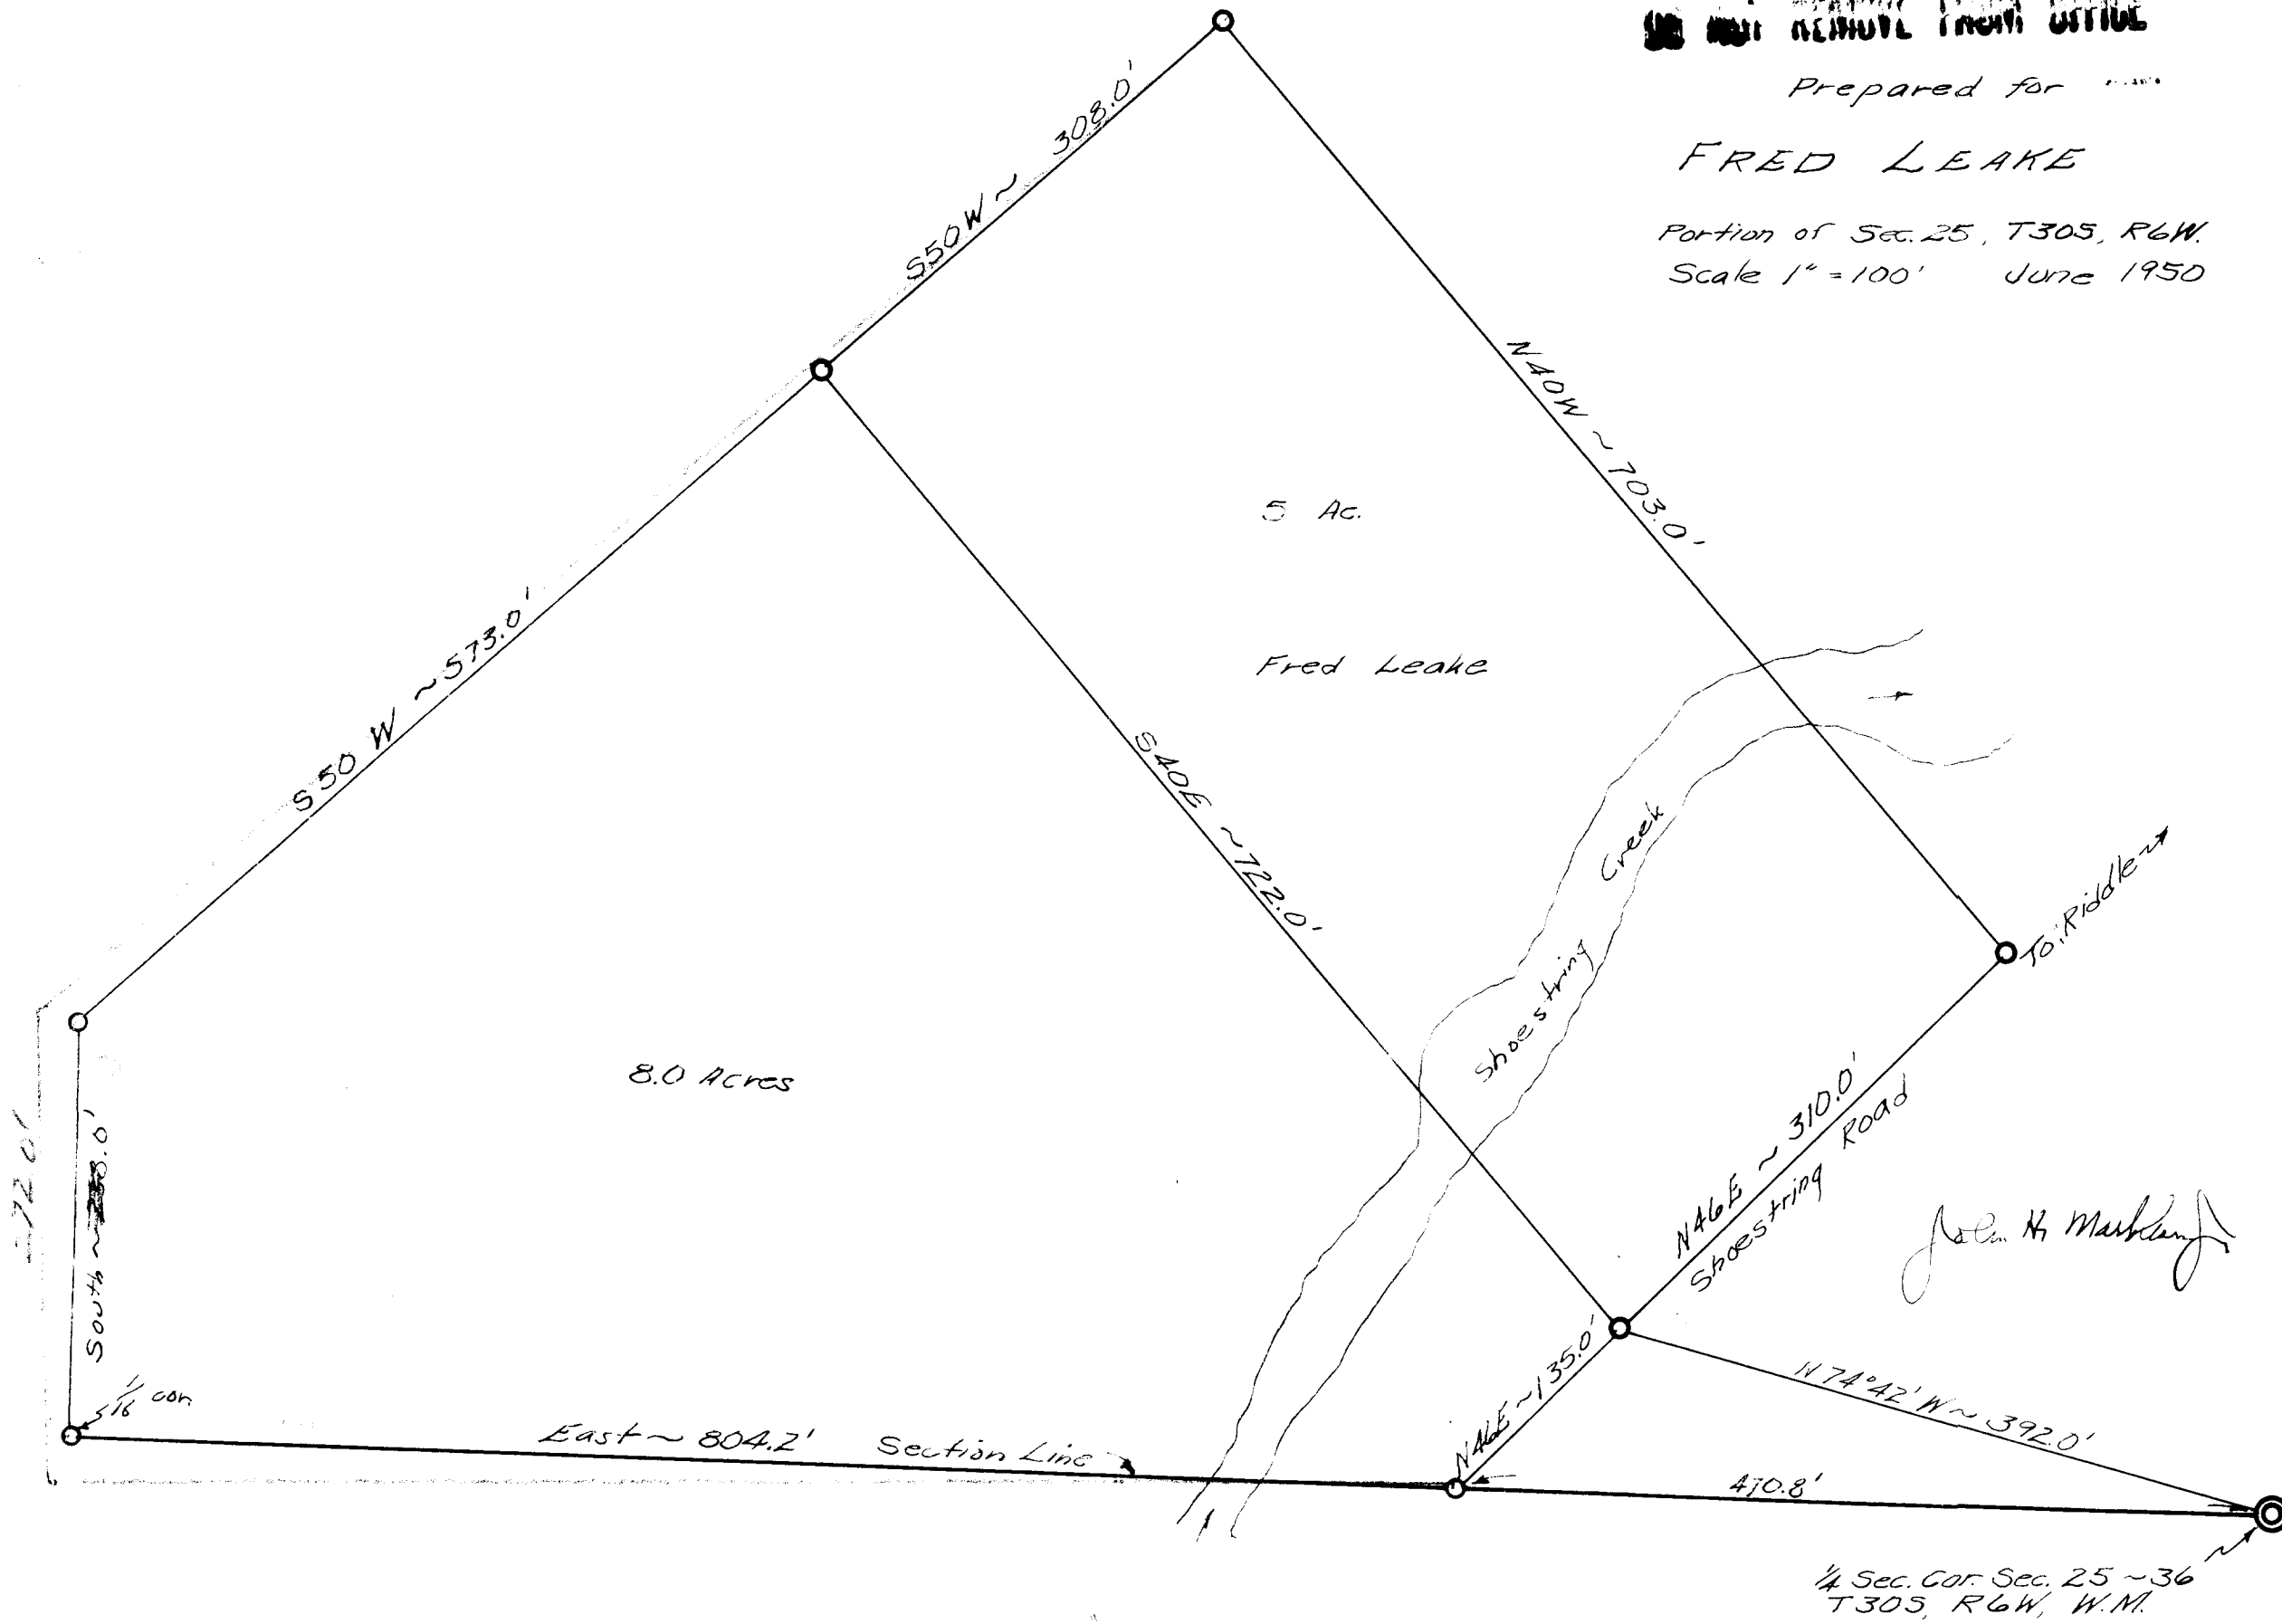

John H. Markland