

COUNTY SURVEYORS FILE DATA
DO NOT REMOVE FROM OFFICE

Prepared for


~ Harry Dayton ~

Portion of Sec. 33-34, T30S, R6W, W.M.

Scale 1" = 100' Oct. 1953.



North

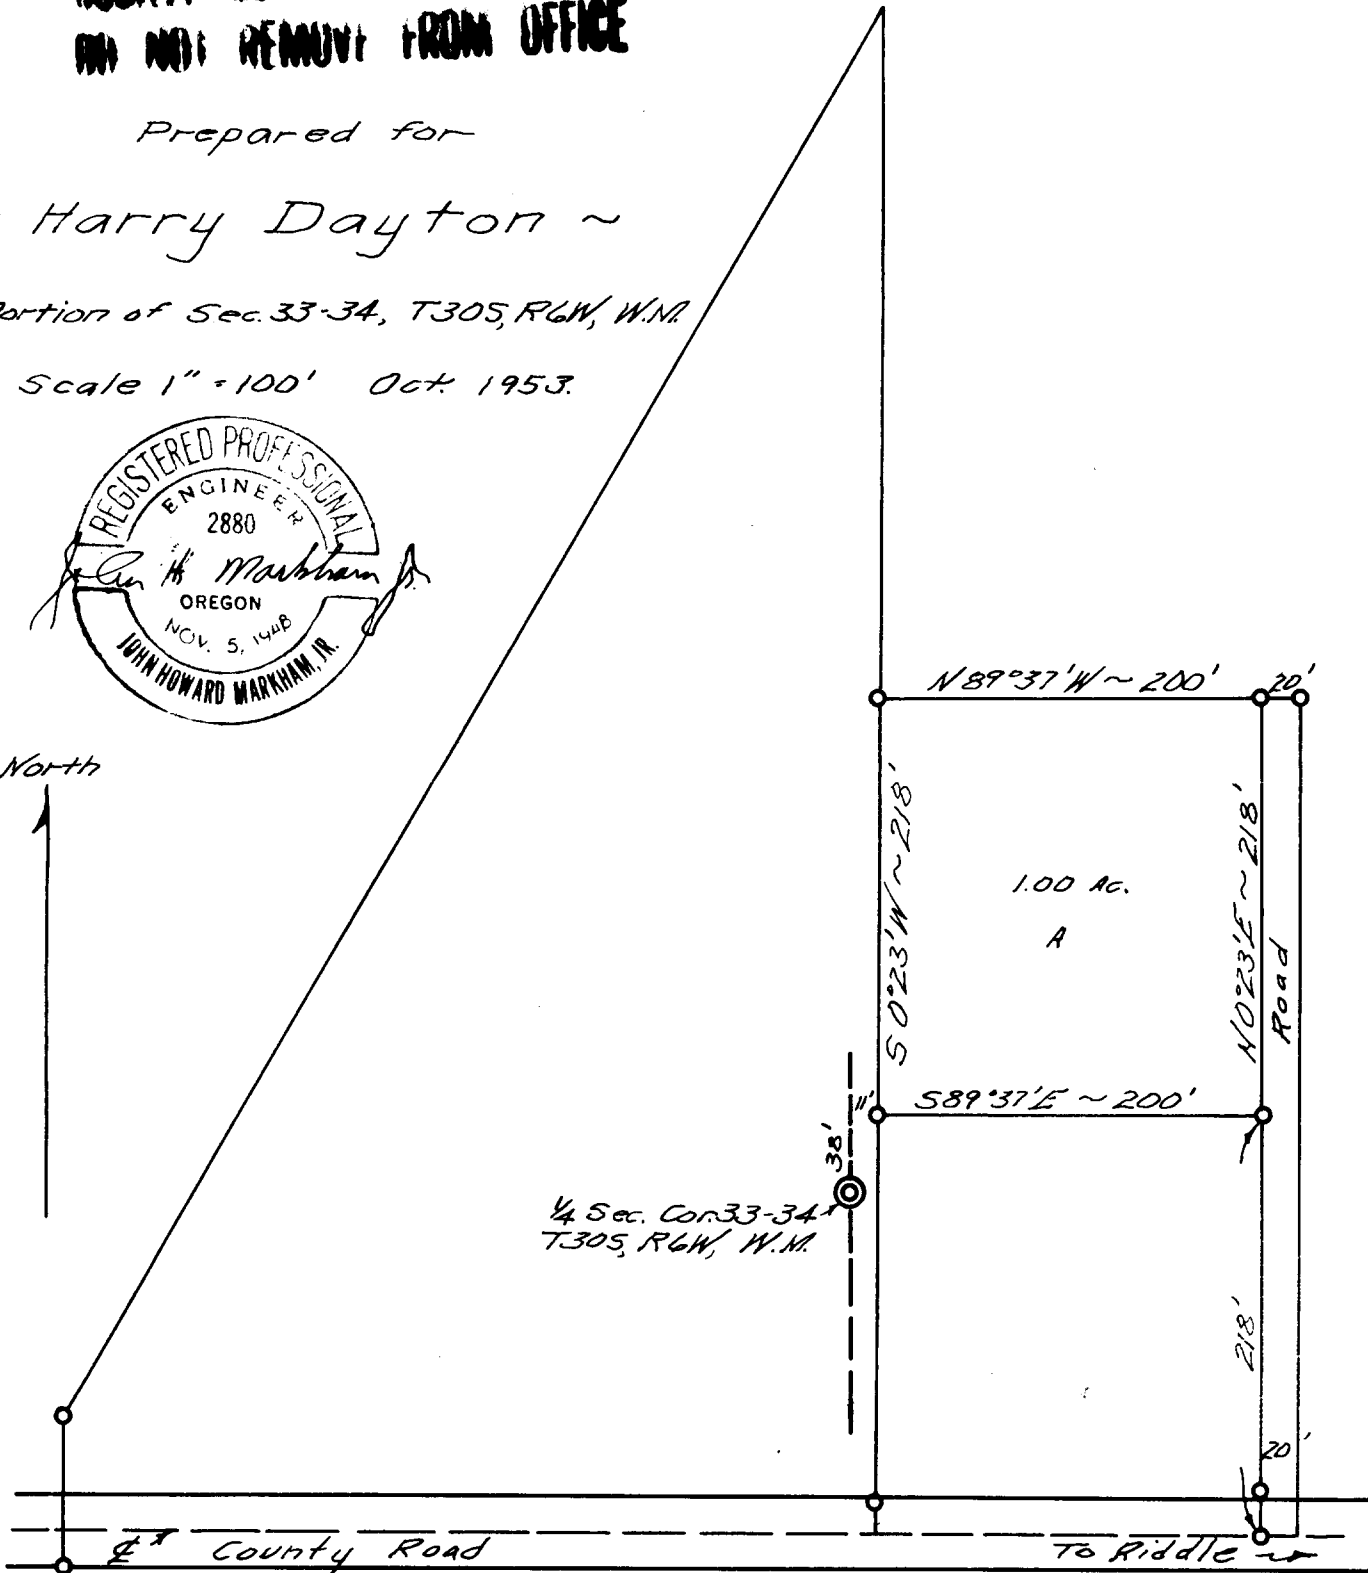

FILED
RECEIVED

COUNTY SURVEYOR
CLATSOP COUNTY