

Jan. 18, 1961.

S. E. Cor. 32, T31S R1W, W.M.
as det. by O.B.T.S

30" White Fir bears N88W 37.6'
O.B.T. fd. scribe & remarked
532 B.T.

16" White Fir bears S86W 39.6' O.B.T.

24" Fir stump (Logged) N30E 27.8' O.B.T.

At cor. pt. set 1" x 3/8" I.P.

from which

5" Fir bears S39W 15.5' dist.
mkd. 55 R1W B.T.


5" Fir bears N41W 20.7' dist.
mkd. 532 B.T.

A Fence bears North and also
West from corner.

Road bears North 3.55°'

Witness: O. A. Keatley

John H. Mudd

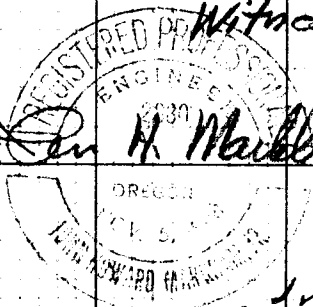

J.V.C. S. File No. 51/142²

Work done for Stomar Her. Co.