


FILED
RECEIVED

NOV 1960

COUNTY SURVEYOR
DOUGLAS COUNTY, ORE.

REEDSPORT
SCHOOL
DISTRICT
No. 105C.
Vol. 227
Rec. No. 167495

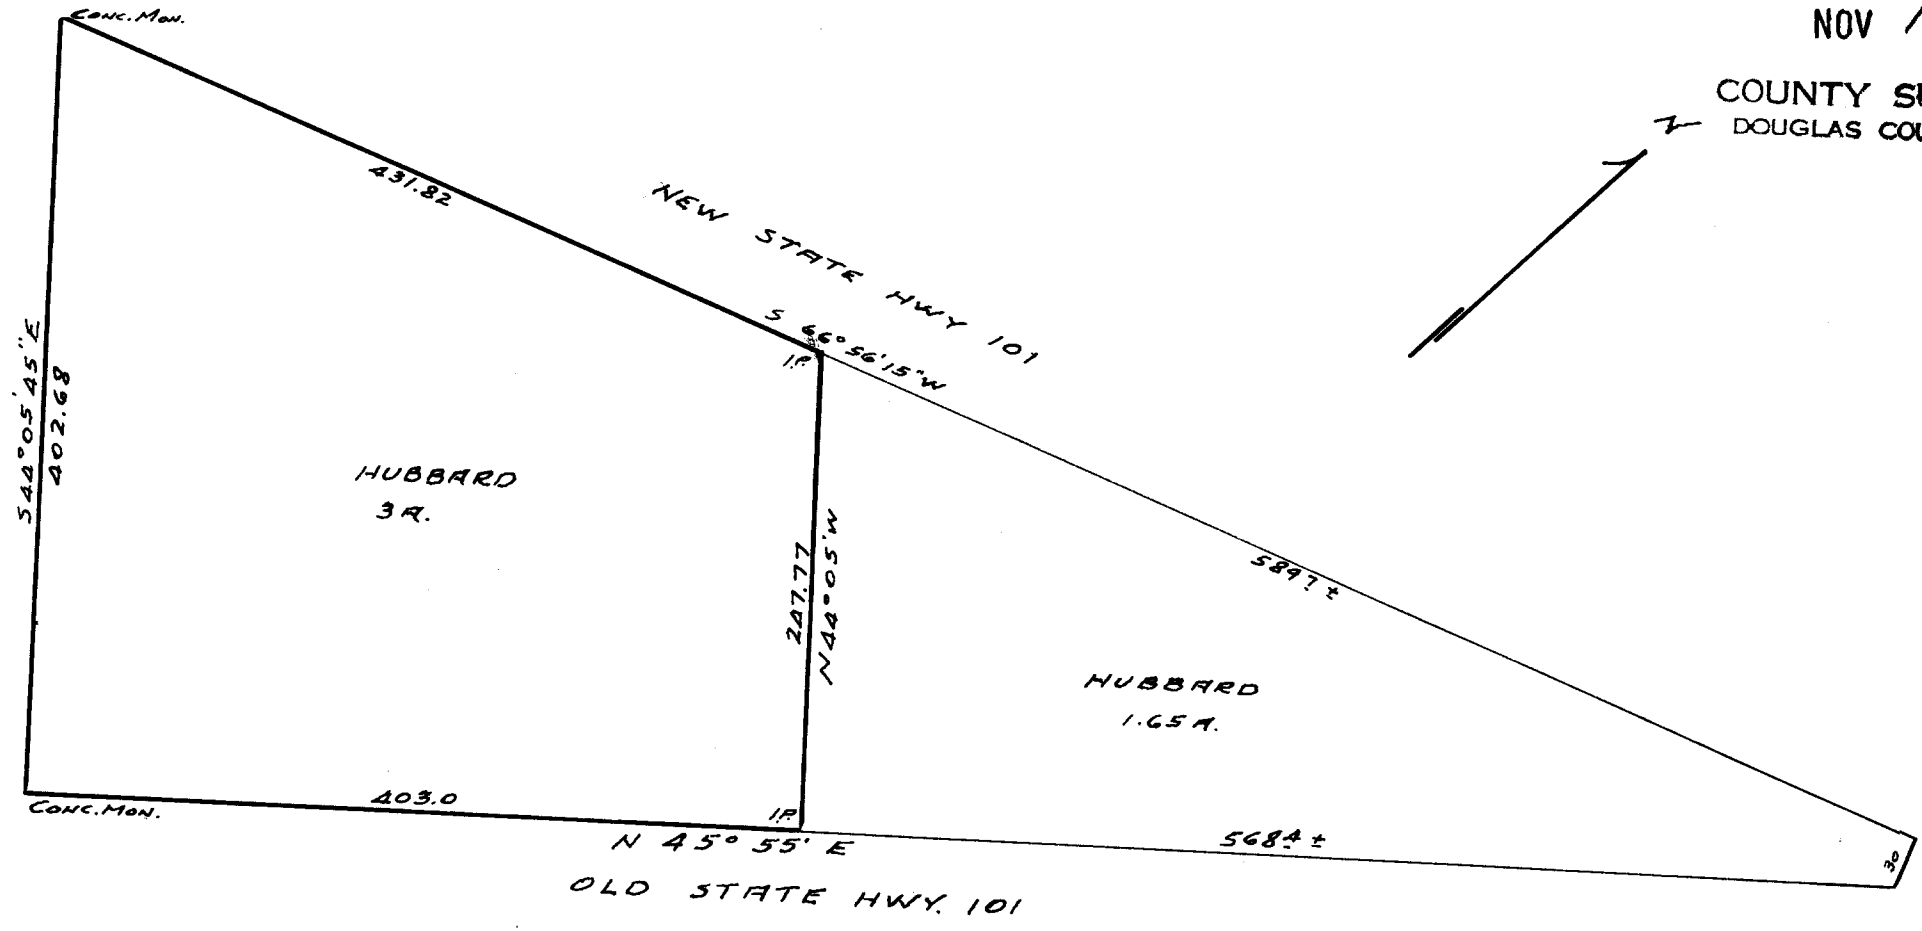

COUNTY SURVEYORS FILE DATA
DO NOT REMOVE FROM OFFICE

SURVEY
JOHN K. HUBBARD
SEC 4, T. 22 S., R. 12 W., W. M.
DOUGLAS COUNTY
Scale 1"=100' Nov. 1960.