

Renew the following section corner for
Roseburg Lbr. Co.:

The corner for sections 23, 24, 25, + 26
T31S, R7W, W.M.

found. 34" Fir S40E 19¹/₂ ft. (Bark scribed
and now a snag)

Set: 1" x 30" Iron Pipe

Scribed: 12" Cedar N62¹/₂° E 25⁹/₁₆ ft

6" Fir S78E 11²/₁₆ ft.

34" Fir S06W 43° ft.

5" Fir N09W 20⁷/₁₆ ft.

Witness:


R. J. Hennikson

Elmer Clark.

Jan 30, 1963



Howard W. Johnstone

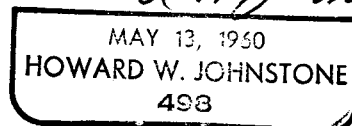

FILED
RECEIVED

FEB 13 1963

COUNTY SURVEYOR
DOUGLAS COUNTY, ORE.

C. S. File No. 54/163¹⁰

+ O ✓
▲