

The following corner has been renewed for  
Roseburg Lumber Co: T30-7.W <sup>changed  
per  
No. 1. 63  
10 7. 63  
L.H.</sup>

1/4 corner between sections 16 and 17, T30S, R7W.  
Found: Original corner tree now 12" diameter D. Fir.

6" D. Fir S60E 9.2 ft. (Now 16 in. dia.)

Scribed: 12 in. D. Fir S44 1/2° W 23 5/8 ft,

✓ ⊕

8/73  
NOT FOUND  
SEE  
ATTACHED  
NOTE.

closing corner for Sections 1 and 12 T24S, R8W. <sup>8</sup>

Found:

10" D. F S69W 12.7 ft (renewed B.T. now a stump)

20" D. F N39W 51.5 ft (orig B.T. now 26" stump)

Scribed:

8" W. Fir S05W 48.5 ft.

7" W. Fir N61W 41.1 ft.

Corner falls in west lane of logging road there for  
no iron pipe was set.

Witness:

R. J. Henriksen


E. Clark

Sept. 4, 1963.

✓ ⊕



Howard W. Johnstone

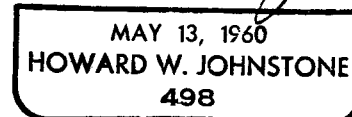

T309-R7W

After long search Did not  
find 1/4 cor 517/518 following  
BLM Route description - REN. # 50  
C.S. 51/163

Fd. O.K. Sec. Cor. 518/519  
1972 CAD B.T.S. 519/520  
B.C. Buried in Road -

7-30-73

C.S. 51/163

T235 R10W - REN # 66  
✓ Fd. O.K. 534/535 I.P. 7 B.T.S.

No need for Renewal!

7-31-73

✓ Fd. O.K. 1/4 cor 512/513 - REN. # 62

7-31-73

ok [Signature]

C. S. File No. 56/35