

Renewed the following Corner
for Roseburg Lumber Co.

1/4 corner between sections

25 and 26 T 30S R 9W


Found: 24" Fir (now 38 inches)
N 19°W 21.1 feet bark scribe
visible — Tree blown down.

Scribed following new B.T.'s

11" W. Fir S 14 W 78⁶ ft.

8" W. Fir S 75 E 70⁵ ft.


Corner falls in west edge of
12 mile creek so ~~no~~ ^{REGISTERED SET}
witness.

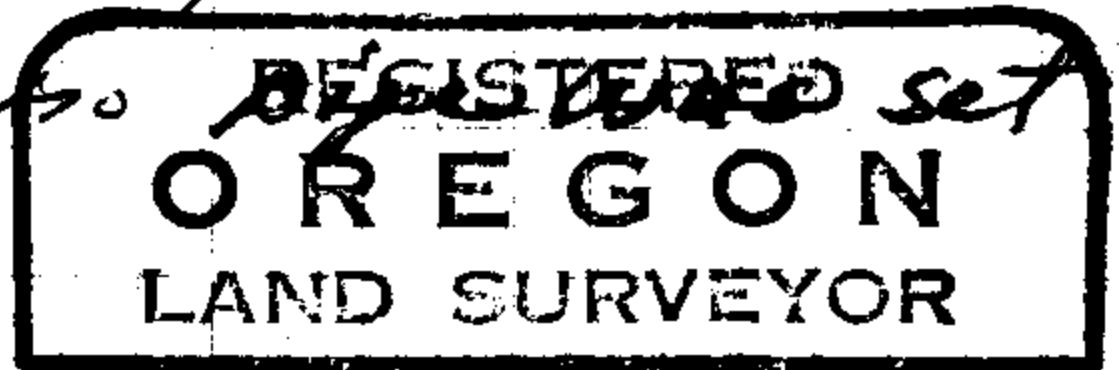

RJ Henrickson
J. Clark.

Howard W. Johnstone

May 28, 1964

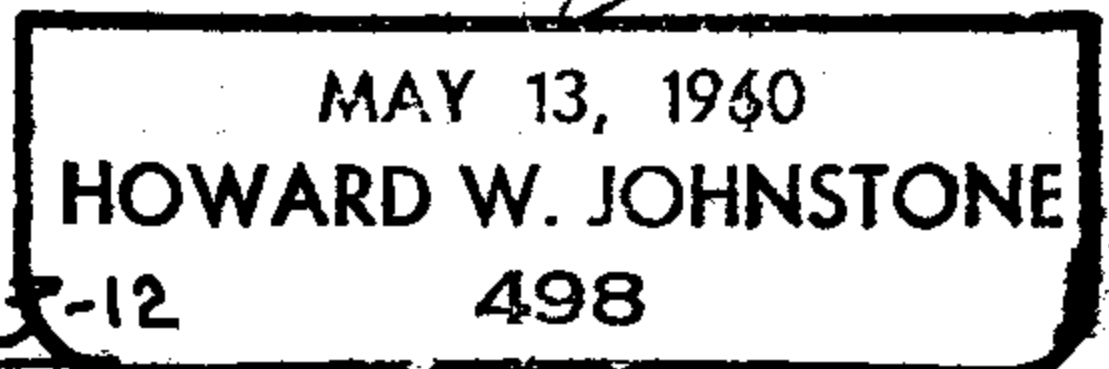

C. S. File No. 51/163-12

498