
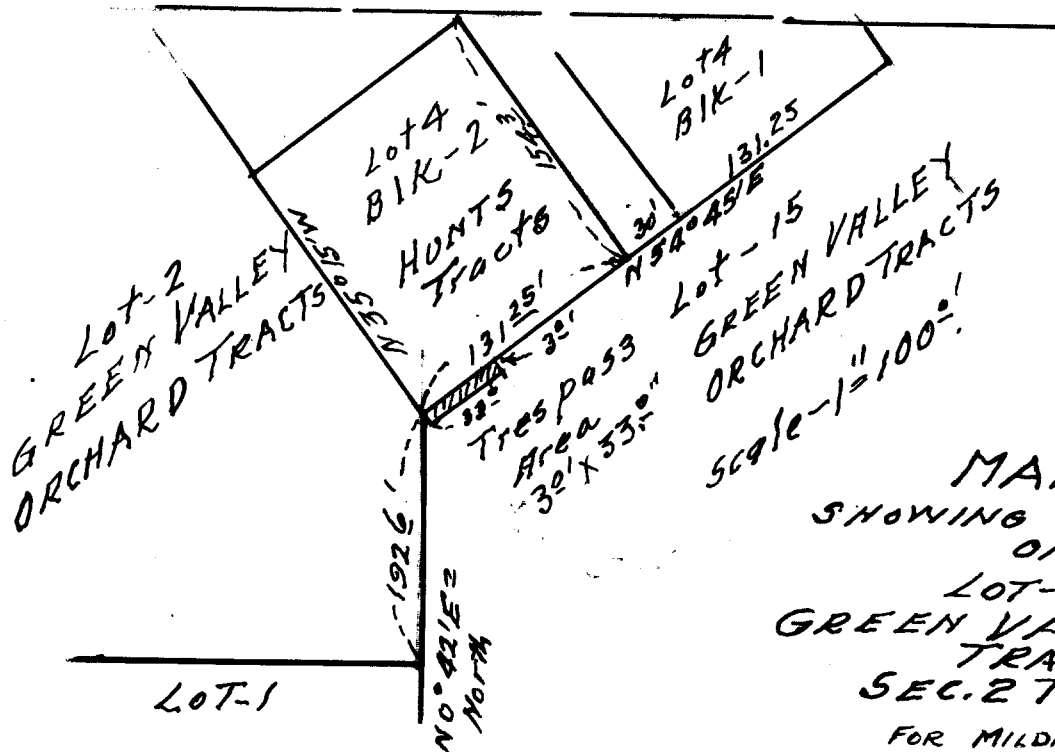
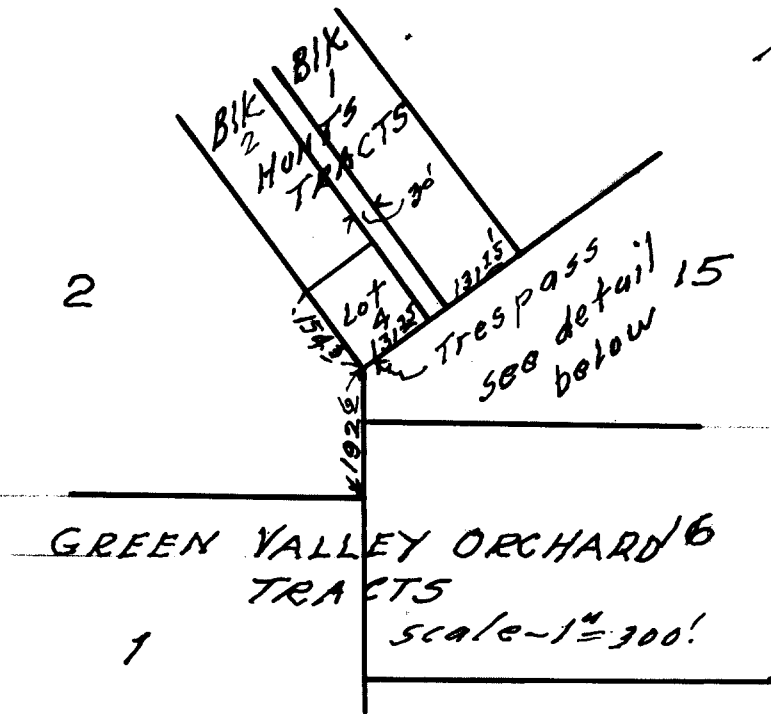
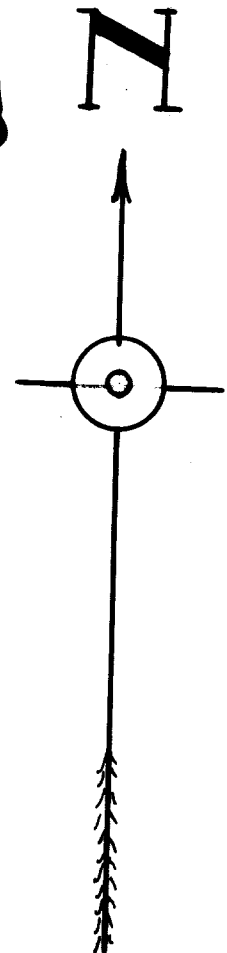


FILED L.L.
RECEIVED

FEB 1961

COUNTY SURVEYOR
WILLAMETTE COUNTY, OREG.

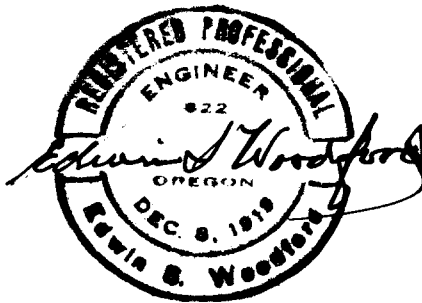

MAP
SHOWING TRESPASS
ON
LOT-15
GREEN VALLEY ORCHARD
TRACTS
SEC. 2 T1285-B96W WM.
FOR MILDRED RIEF

COUNTY SURVEYORS FILE DATA
DO NOT REMOVE FROM OFFICE