

CC 6 | 5, I FIND COR.  
AS RENEWED BY COUNTY  
SURVEYOR, 1953, A STONE 6  
MOUND,

14" W. FIR B. T. S 61° W,  
93.2' (ACTUAL 91.6')  
NOW DEAD

I SCRIBE NEW B.T.'S:  
8" MAPLE, S 1° 40' W, 106.9'  
5" W. OAK, NORTH, 55.6'  
NO. OTHER LIVE TREES AVAILABLE

FOUND 5/4 COR. SEC. 32 AS RENEWED  
BY COUNTY SURVEYOR, 1953

1410.85'

LOT 4

4062.96' RECORD = 4028.10' MEAS.

1308.62'

LOT 5

SET BY PROP. MEAS., A  
1" I. PIPE, I SCRIBE:  
18" W. FIR, N 17° 10' W, 16.2'  
6" YE W, S 65° 40' E, 11.3'

RANDOM LINE  
EAST 1319.0'

1308.63'

LOT 12


FOUND ORIG. STONE, SEC. 6  
1/4" VISIBLE, 2 ORIG. B.T.'S  
PER GOVT. NOTE, GOOD  
COND.

1/4 COR. SEC. 5

D. FIR TO NE NOW 16" DIA.  
MAD. TO SW NOW 22" DIA.

COUNTY SURVEYORS FILE DATA  
DO NOT REMOVE FROM OFFICE


N

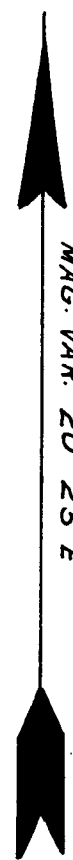

FILED L. L.  
RECEIVED

FEB 7 1960

COUNTY SURVEYOR

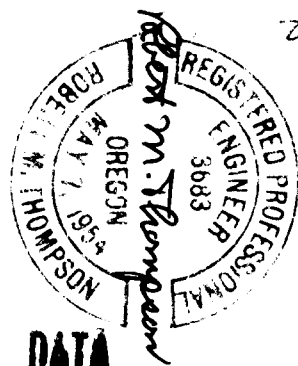

# SURVEY TO ESTABLISH SW COR. OF LOT 5

SEC. 5, T 32 S, R 1 W, W.M.

SCALE: 1 IN. = 500 FT

FEBRUARY 8, 1960

R.M. THOMPSON

DONE FOR JOHN TOUMEY

SEE RM 2 - 21 - SHANEY'S SURVEY

51/171-1