

28 27 1/4 COR.

FOUND CEDAR POST FROM WHICH
14" MAPLE, BRS. S31 1/2° E, 32.4 FT.
12" MAPLE, BRS. S64° W, 15.0 FT.

1/4 COR. 27 26

FOUND 15" B.O. (NOW HOLLOW SHELL) N10° W,
66 FT., PER GOVT. NOTES
A DEPRESSION IN GROUND FOR
15" B.O., S50° E 36.3 FT.
I FIND TWO NEW B.T.'S FACED; NO SCRIBING
32" FIR, N44° E, 64.2 FT. (I SCRIBE)
26" Y.P., S74° W, 62.6 FT. (I SCRIBE)

**COUNTY SURVEYORS FILE DATA
DO NOT REMOVE FROM OFFICE**



S 1/6 COR. SET 3/4" I.P. FROM WHICH I SCRIBE
32" FIR, N17° E, 19.9 FT.
10" FIR, N11° 15' W, 35.4 FT

S 1/6 COR. 27 & 26 I SET 1" I.P.
I SCRIBE, 10" FIR, S89° 20' E, 105.2 FT.
NO OTHER TREES AVAILABLE.

RANDOM LINE

SURVEY TO SET 1/16 CORNERS ON EAST & WEST SIDES OF S 1/2 OF SEC. 27

T30S, R3W, W. M.


18-22 MAR. 1960

SCALE 1 IN. = 400 FT.

Drawn By R.D.G.

For R. M. THOMPSON

FOR GEORGE MEYERS

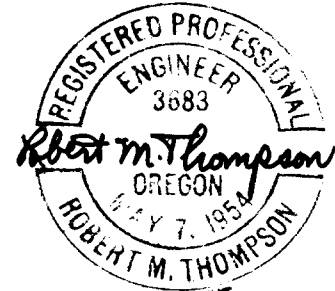

FILED
RECEIVED

FOUND 1" I.P. AT FENCE COR.
ORIG B.T.'S GONE.
NE COR. OF HOUSE BRS. S45° W 60 FT.

FEB 7 1961

FOUND 3 B.T.'S & 3" AXLE 27 26
34 35

COUNTY SURVEYOR
DOUGLAS COUNTY, ORE.

MAG. VAR. 19° 30' E
NORTH 2784.3'

MAG. VAR. 19° 15' E
NORTH 2695.0'

28 27
33 34

27 26
34 35

51172