


LOT 9

LOT 10 BLOCK 2 COOS JUNCTION SUBDIVISION

GREGORY AVE.

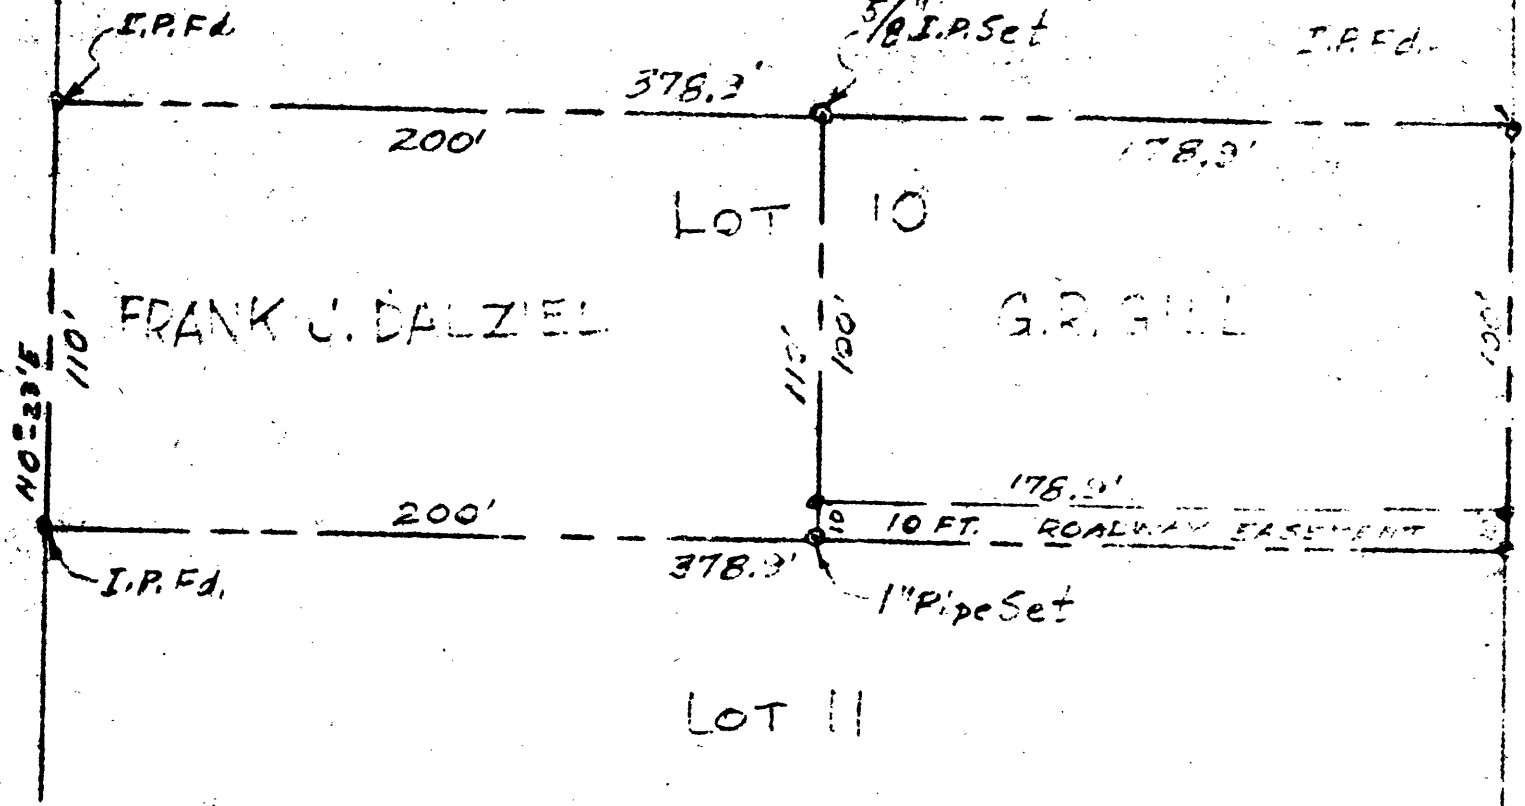

FILED
RECEIVED

MAR 10 1961

SURVEYED BY
JAMES R. DAUGHERTY

CIVIL-SANITARY ENGINEER



SCALE 1"=50'

WINSTON, ORE.

Feb. 21, 1961.

T-28-6-21
C.S. PLAN No. 5482

S.C. J.O.T.

2/16

G. R. GILL