
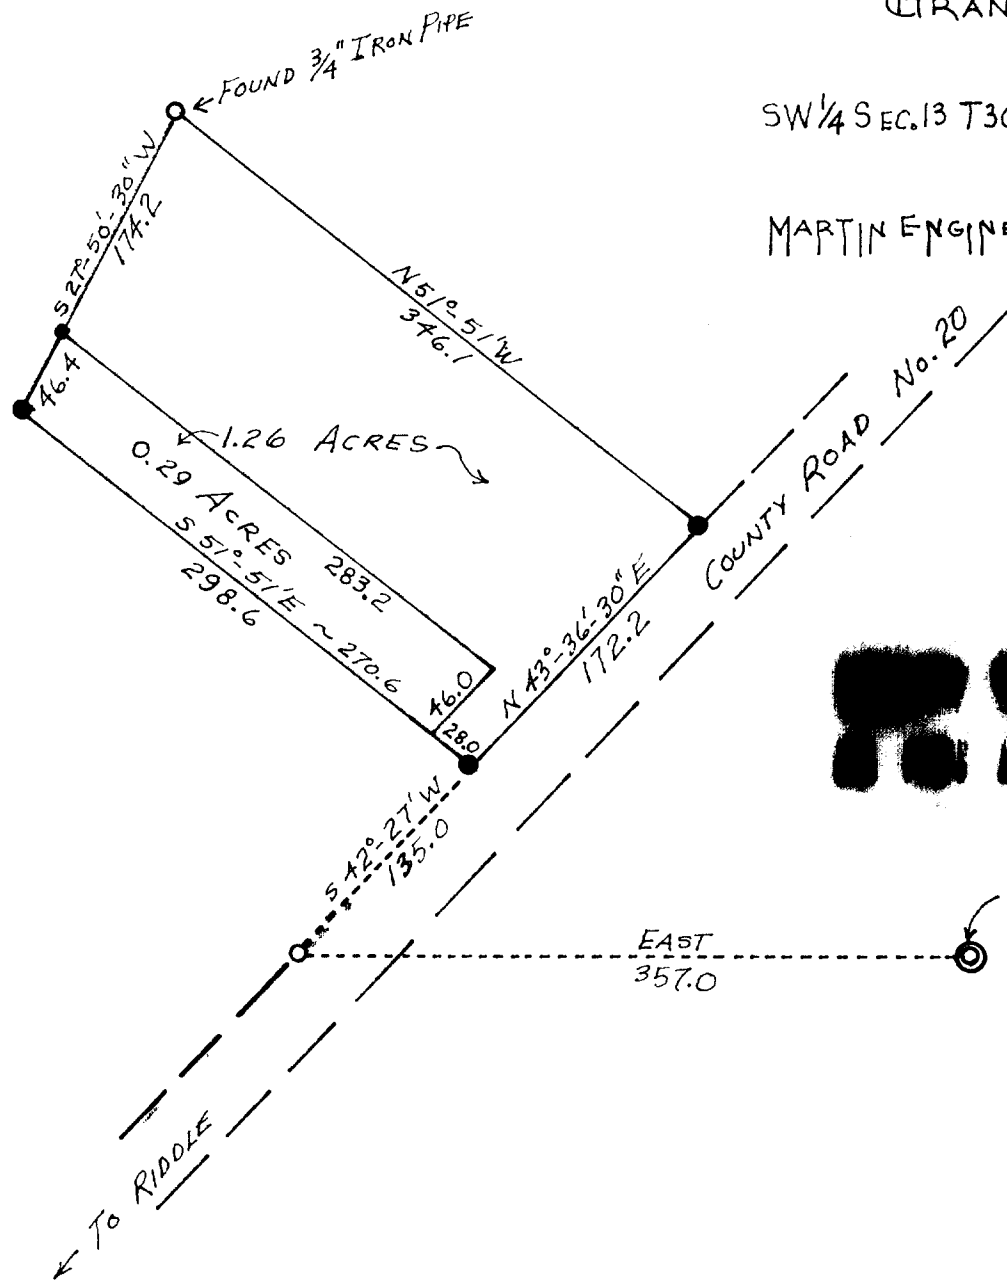


SURVEY & PLAT FOR  
**GRANT WEATHERS**  
 RIDDLE, OREGON

SW 1/4 SEC. 13 T30S R6W W.M. DOUGLAS COUNTY, OREGON

SCALE: 1 IN. = 100 FT.

MARTIN ENGINEERING SERVICE ~ MYRTLE CREEK, ORE.

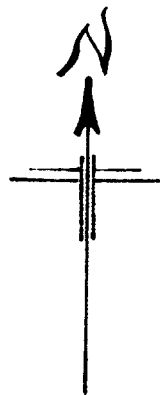

FIELD RECEIVED

COUNTY SURVEYOR  
 DOUGLAS COUNTY, ORE.



• SET 1/2" IRON PIPE



NE CORNER  
 J.Q.C. VANDENBOSCH D.L.C. No. 47

FOUND 1" IRON PIPE

MAY 1961