

PARCEL IN LOT 3 BL. 1 PLAT A - SUTHERLIN L. & W. CO.

T. 25 - 5 Sec. 16

DOUGLAS COUNTY - OREGON

ANTON J. BROWN

N.E. Cor  
Mar Donna Sub

1/2" I.P. Set

S. 79°-10' W 104.97'

S. 79°-10' W  
Set 3/4" Pipe 212.53'


.36 Ac.

MAR DONIA DR. 50'

S 18°-58' E 150.16'

N. 18°-58' W. 150.16'

N.E. Cor. Lot 3 Bl. 1 Plat "A"

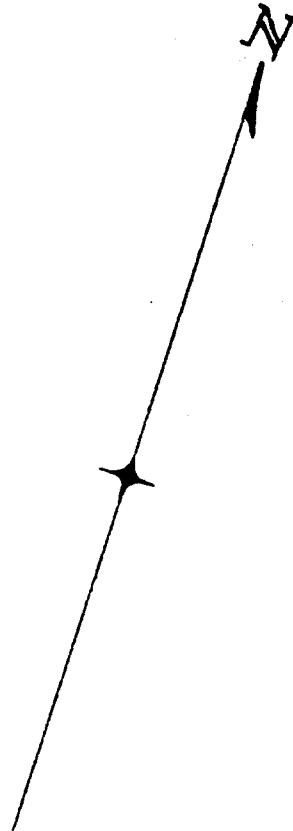

COUNTY SURVEYORS FILE DATA  
DO NOT REMOVE FROM OFFICE

FILED  
RECEIVED

AUG 2 1961

COUNTY SURVEYOR  
DOUGLAS COUNTY, ORE.

File Ed.

N 79°-15' E 105'

Pipe Ed.

5<sup>th</sup> ST.

Pipe Ed.

SURVEYED BY  
JAMES R. DUNN  
CIVIL SURVEYOR ENGR.  
ROSEBURG - ORE.

SCALE 1" = 20'  
AUGUST 12, 1961