

COUNTY SURVEYORS FILE DATA T 26 S R 4 W W. M.

DO NOT REMOVE FROM OFFICE


Survey For Charles S. Dyar

Surveyor Don Garrett


o - Denotes 3/4" Iron Pipe

Dec. 9, 1961

Scale 1" = 100'

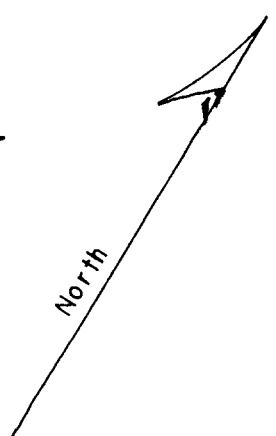

FILED  
RECEIVED

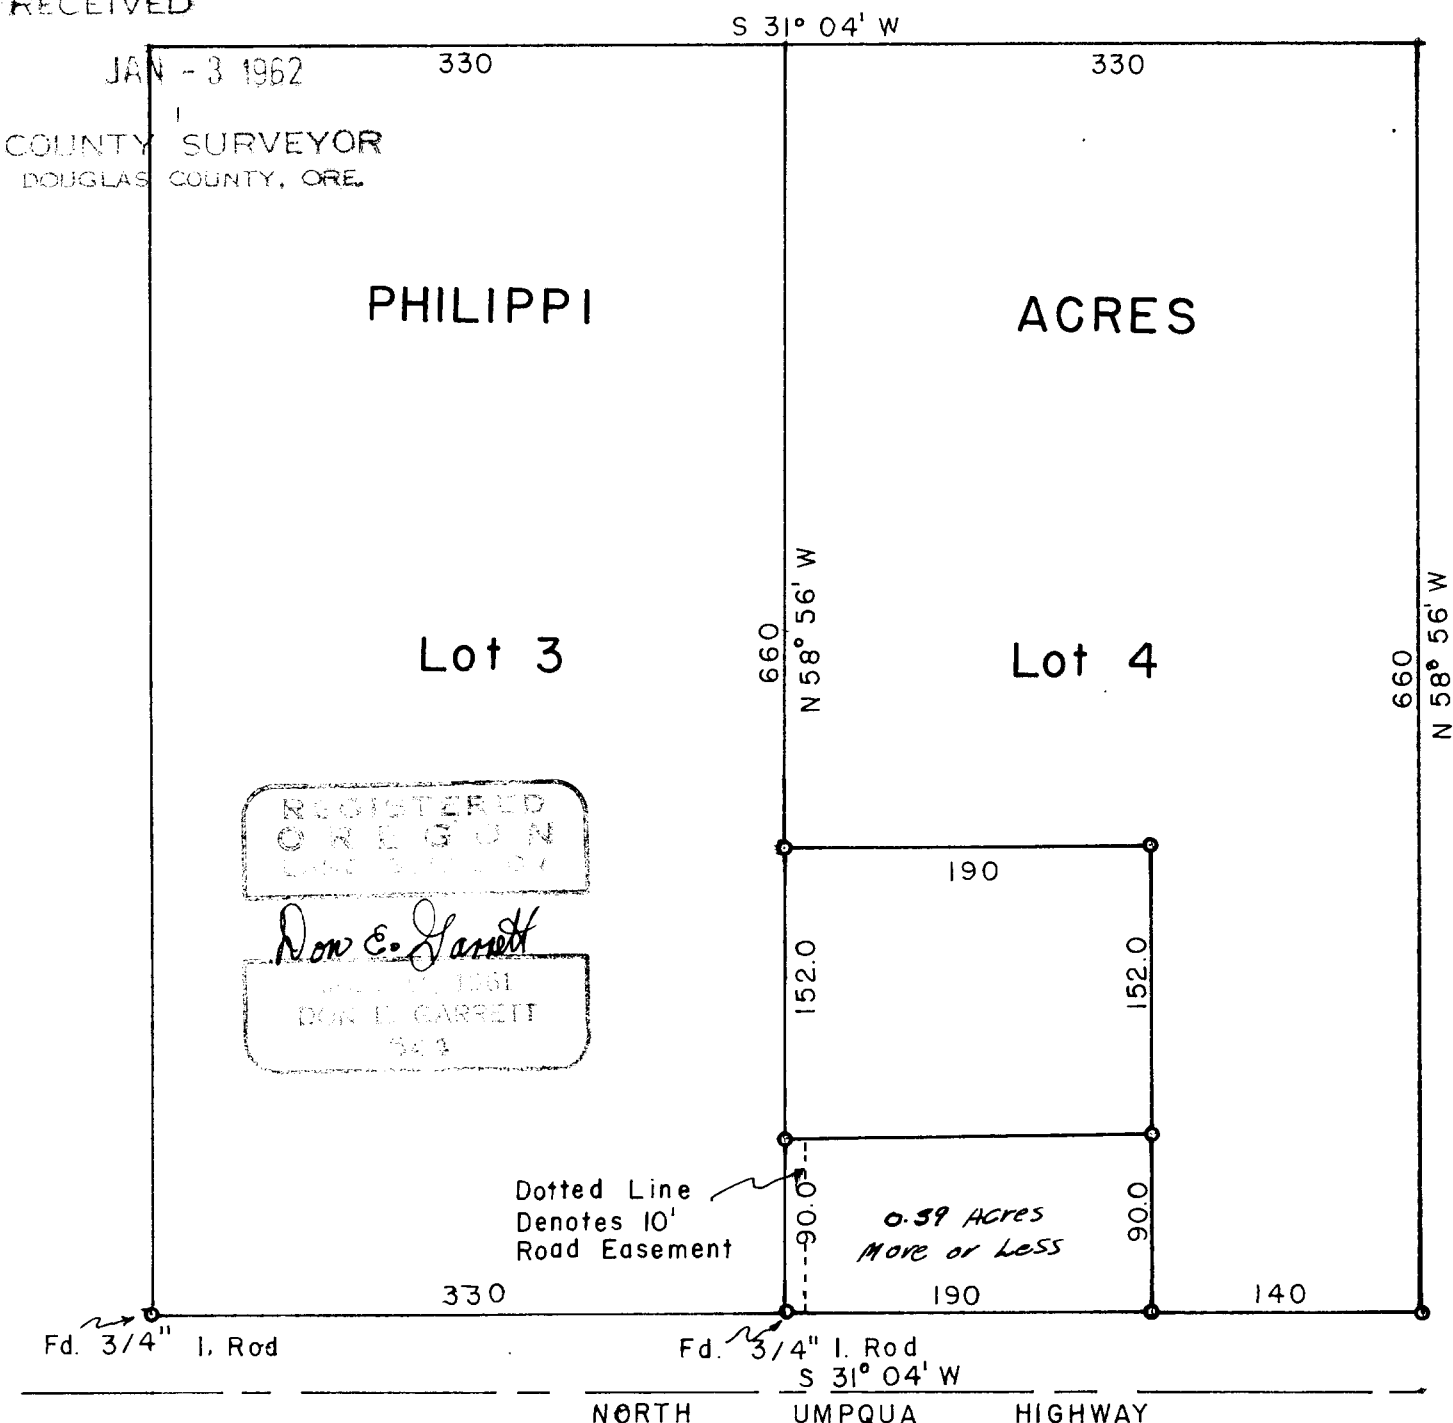

51/211-2