
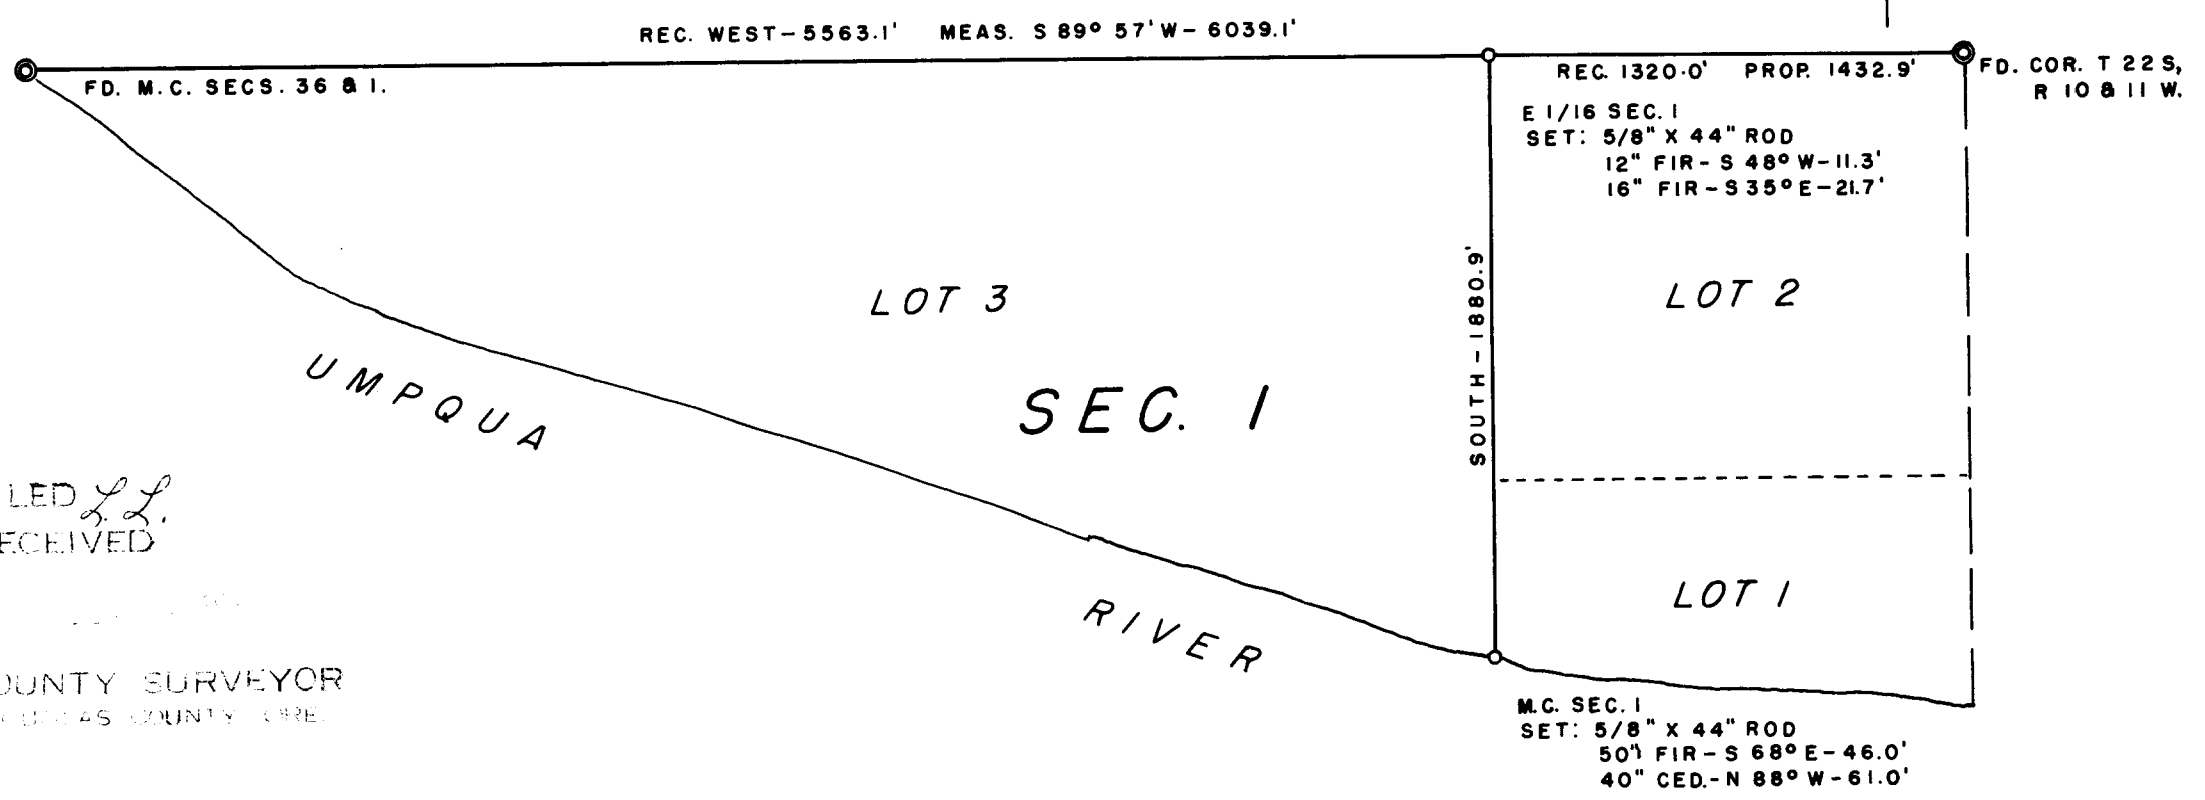


COUNTY SURVEYORS FILE DATE
DO NOT REMOVE FROM OFFICE

SURVEY IN SEC. 1, T.22S., R.11W., W.M.
SURVEYED FOR: REEDSPORT MILLING CO. OCTOBER, 1961
SURVEYED BY: G. R. LECKLIDER-ENGINEER SCALE: 1" = 600'

ALL BEARINGS BASED ON SOLAR OBSERVATION.
NOTE: REFER TO C.S. MAP FILE M8-29

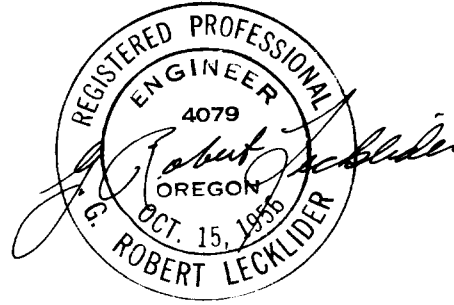

FILED *L.L.*
RECEIVED

COUNTY SURVEYOR
DEWAS COUNTY, ORE.