


PARSON'S PARCELS IN D.L.C. 49 T25S-R4W

DOUGLAS COUNTY OREGON

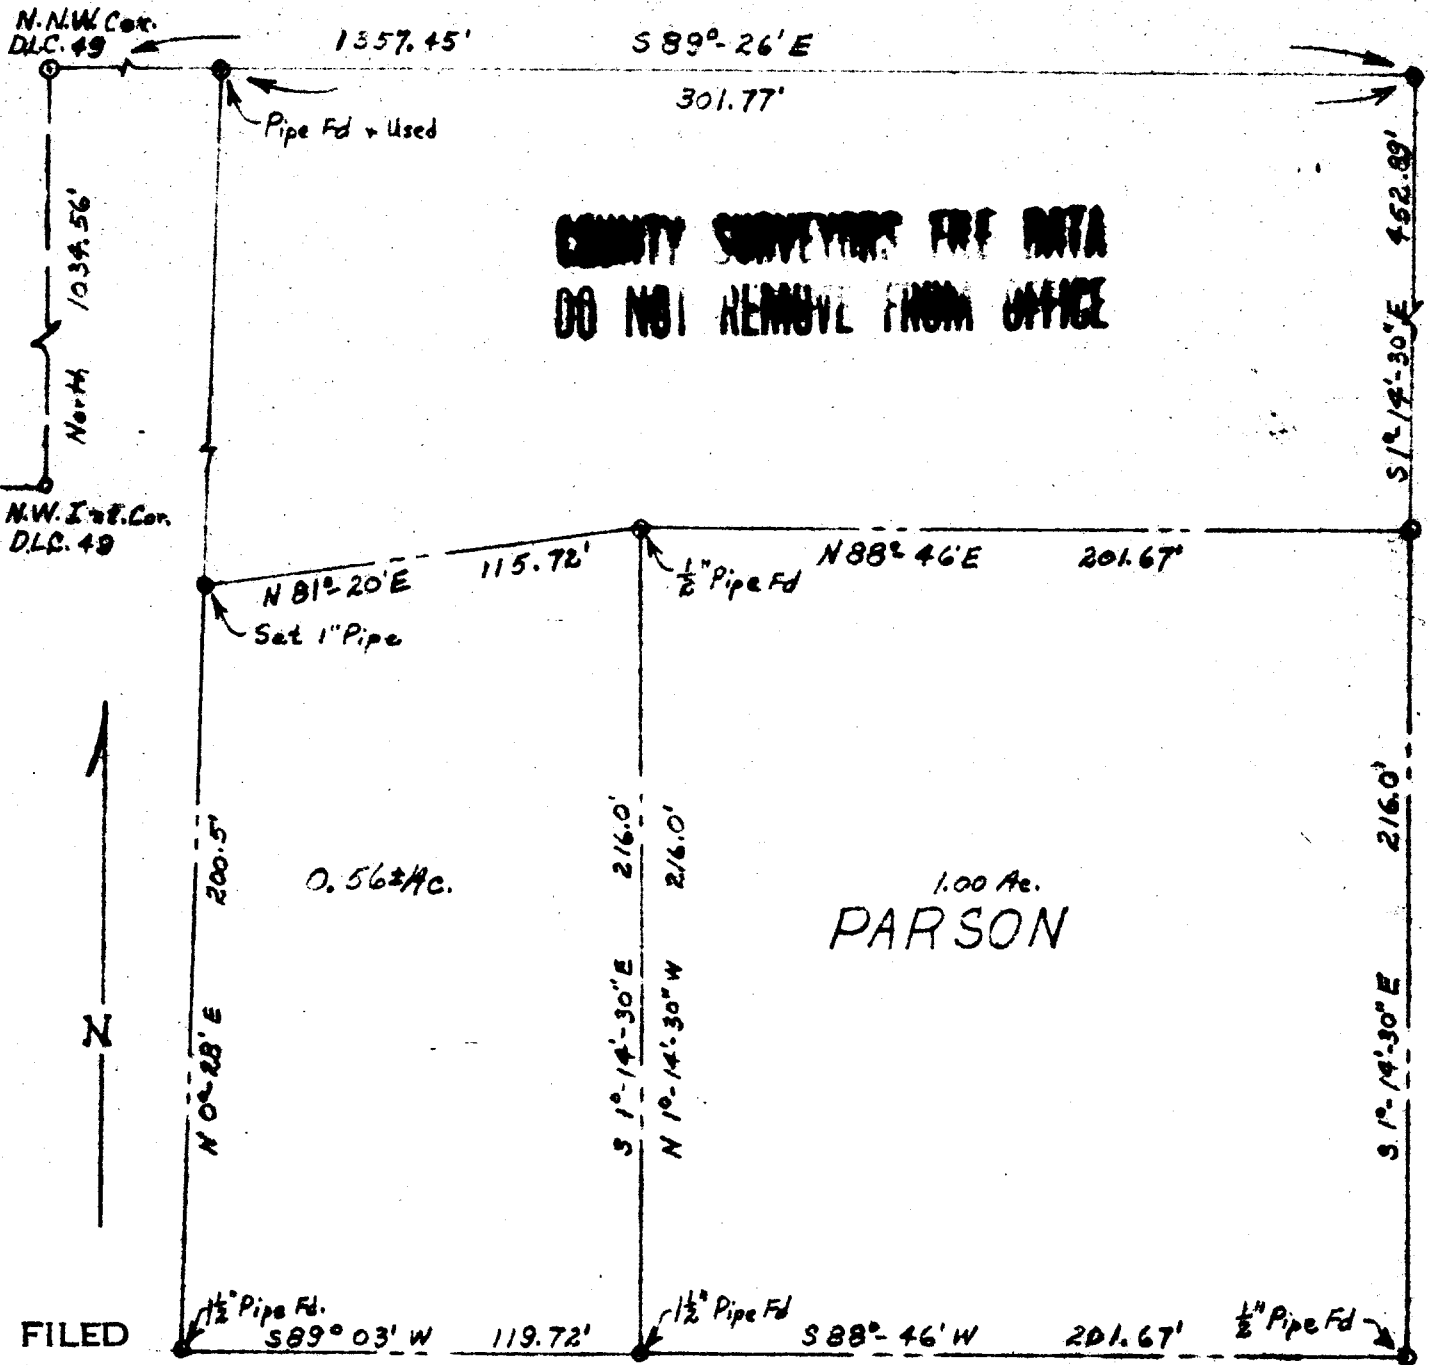

**COUNTY SURVEYORS FIRE DATA
DO NOT REMOVE FROM OFFICE**

E.S. FILE NO. 511212