


Prepared for  
 ~ J. H. WADE & L. H. GOTTSCH ~  
 showing  
 Lot 15, Plat "C" of the N. Curry Estate, Douglas Co. Ore.  
 Scale 1" = 100' Oct. 16, 1963 J. H. Markham, Jr.

COUNTY SURVEYORS FILE DATA  
 DO NOT REMOVE FROM OFFICE

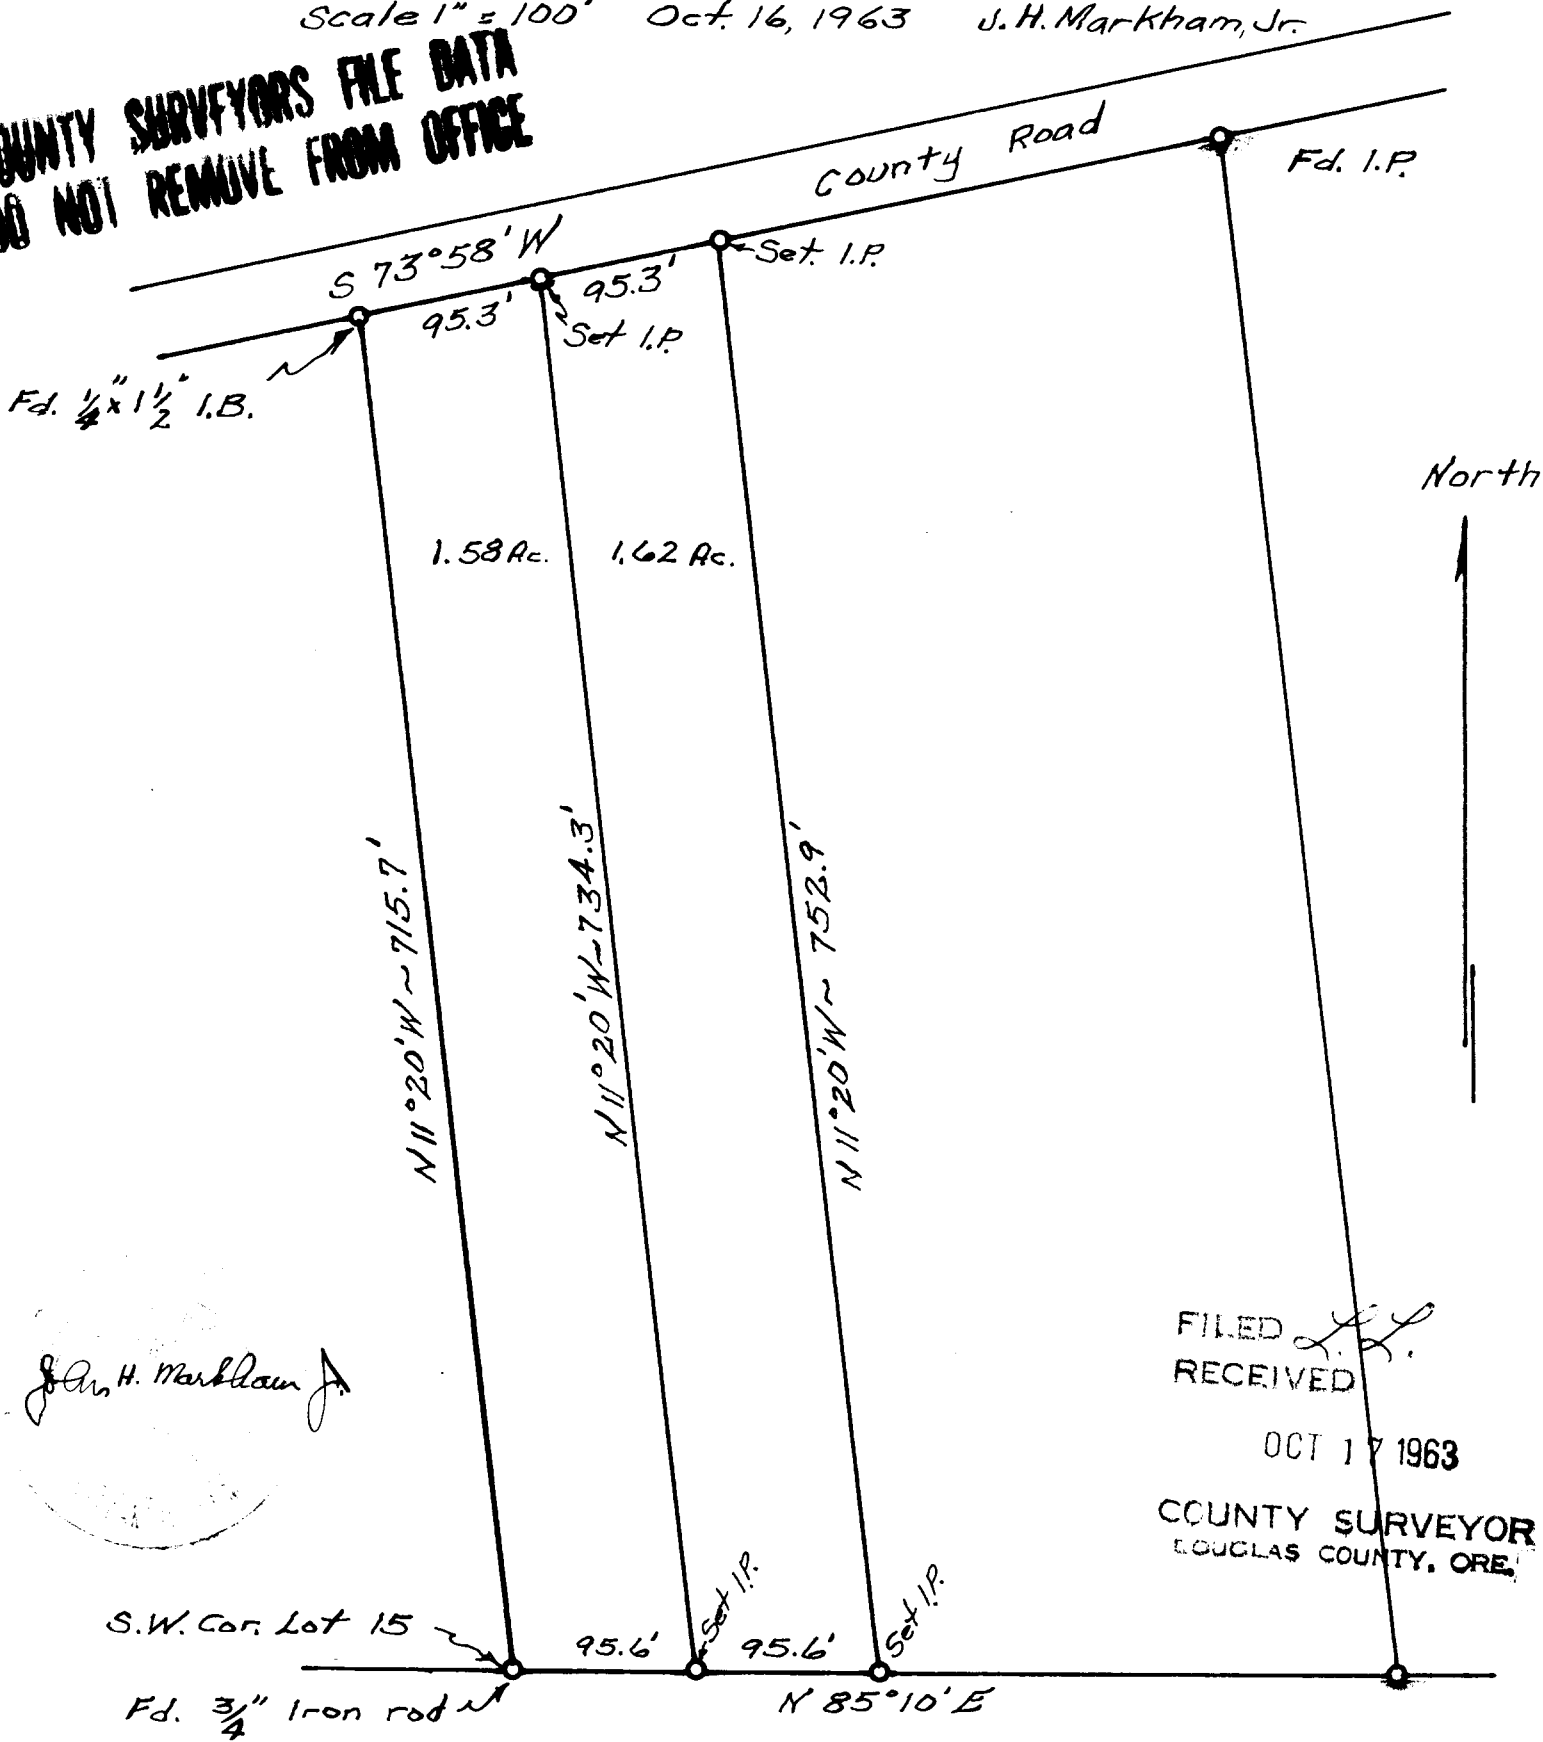

J. H. Markham Jr.

C. S. File No. 51/221