

Wilford N Haines
Drain Oregon
Dec. 14, 1961.

T 215 R 6W

At $\frac{1}{4}$ Sect. Cor. Sects. 6 + 7

Fd. Rock Marked $\frac{1}{4}$ S.

Both old B.Ts. are rotten fir stabs. (No scribe)
Set 1" x 1" x 36" T. Iron by Rock
scribed

18" D. Fir S. 06° W. 15.8 ft.

12" D. Fir N. 30° W. 40.5 ft.
This tree has forked top + 0

At $\frac{1}{4}$ Sect. Cor. Sects 6 + (7, T. 215, R. 7W.)

Fd. 1" x 1" x 36" T. Iron



old B.T. in sect. 1 is down

old B.T. in sect. 6 still standing

Rescribed B.T. on same tree

scribe New tree 36" D. Fir

S. 27 $\frac{1}{2}$ ° W. 36.8 ft.

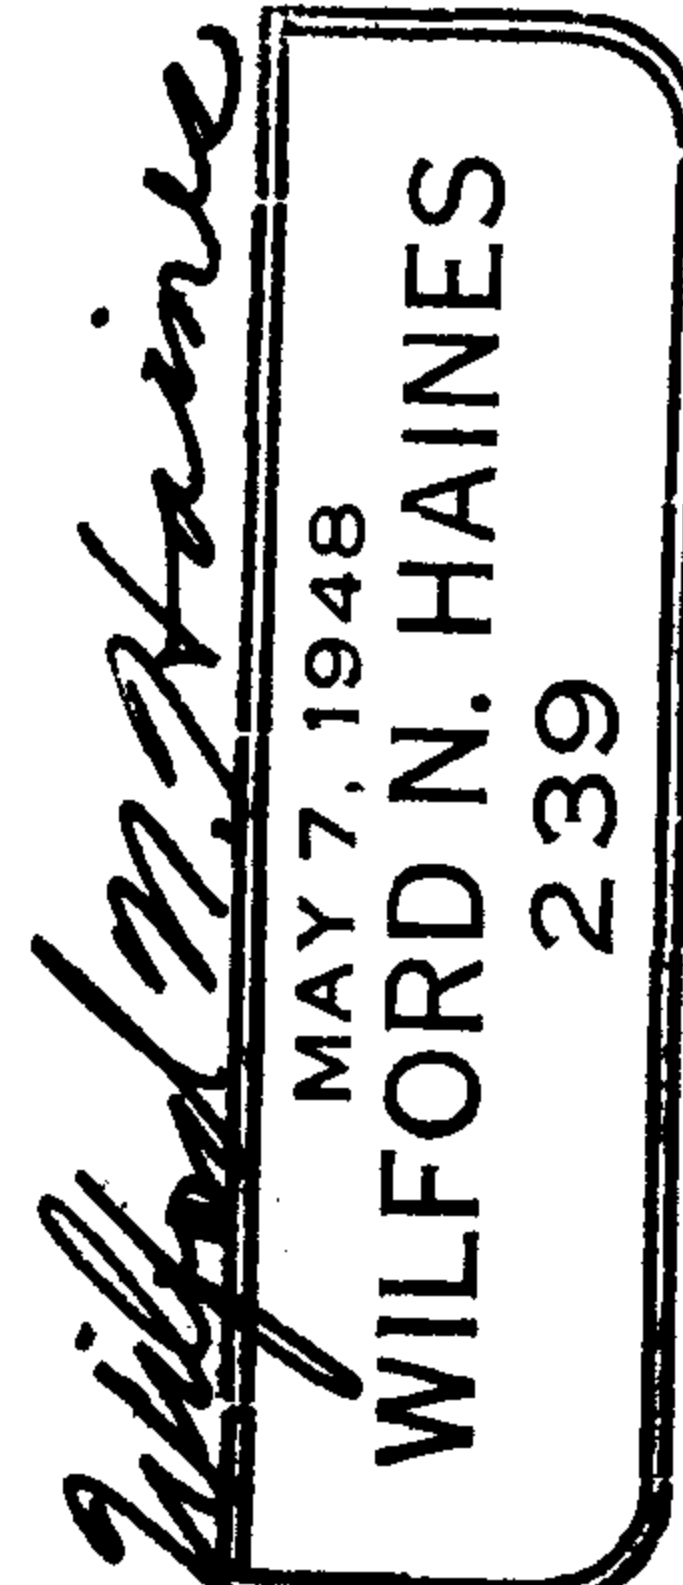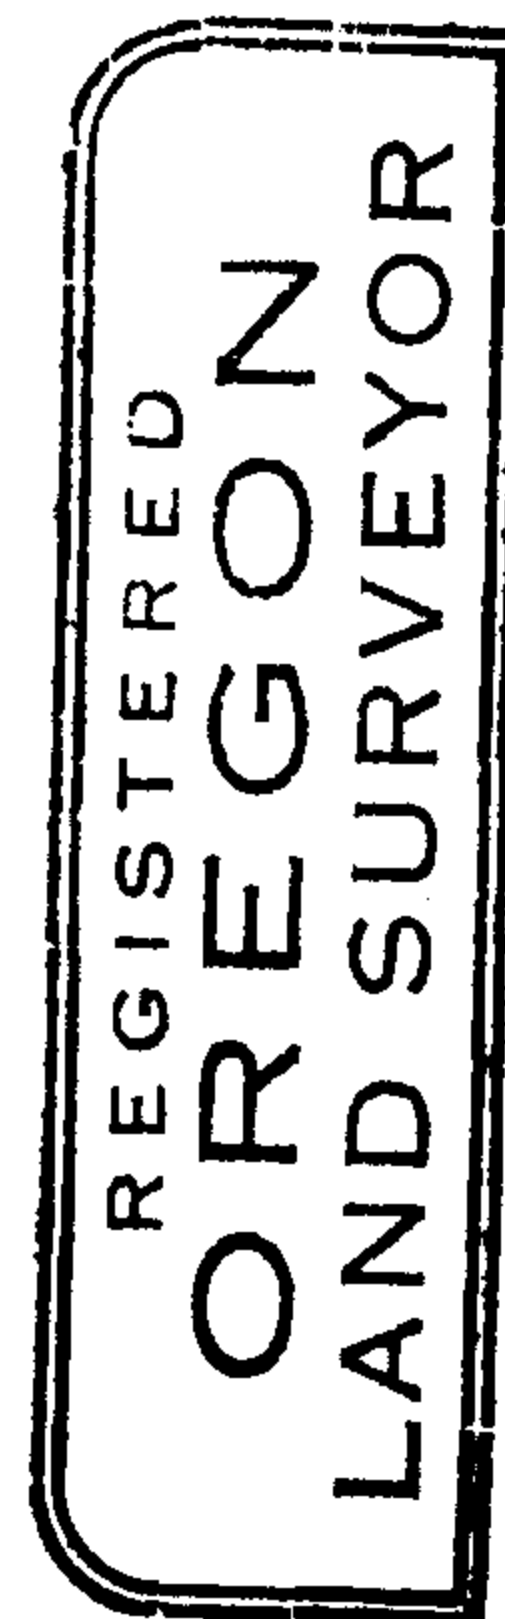

+ 0

At $\frac{1}{4}$ S. Cor Sects. 5 + 6

Fd. Cor. tree and both B.Ts. dead + down

drowe 1" x 1" x 36" T. iron 0.5 ft. South of orig. Cor. Tree
scribed

16" D. Fir West 46.7 ft.

16" D. Fir S 39° E 17.3 ft.

+ 0

O U P R