


LOOKING S. - RESTON RD.

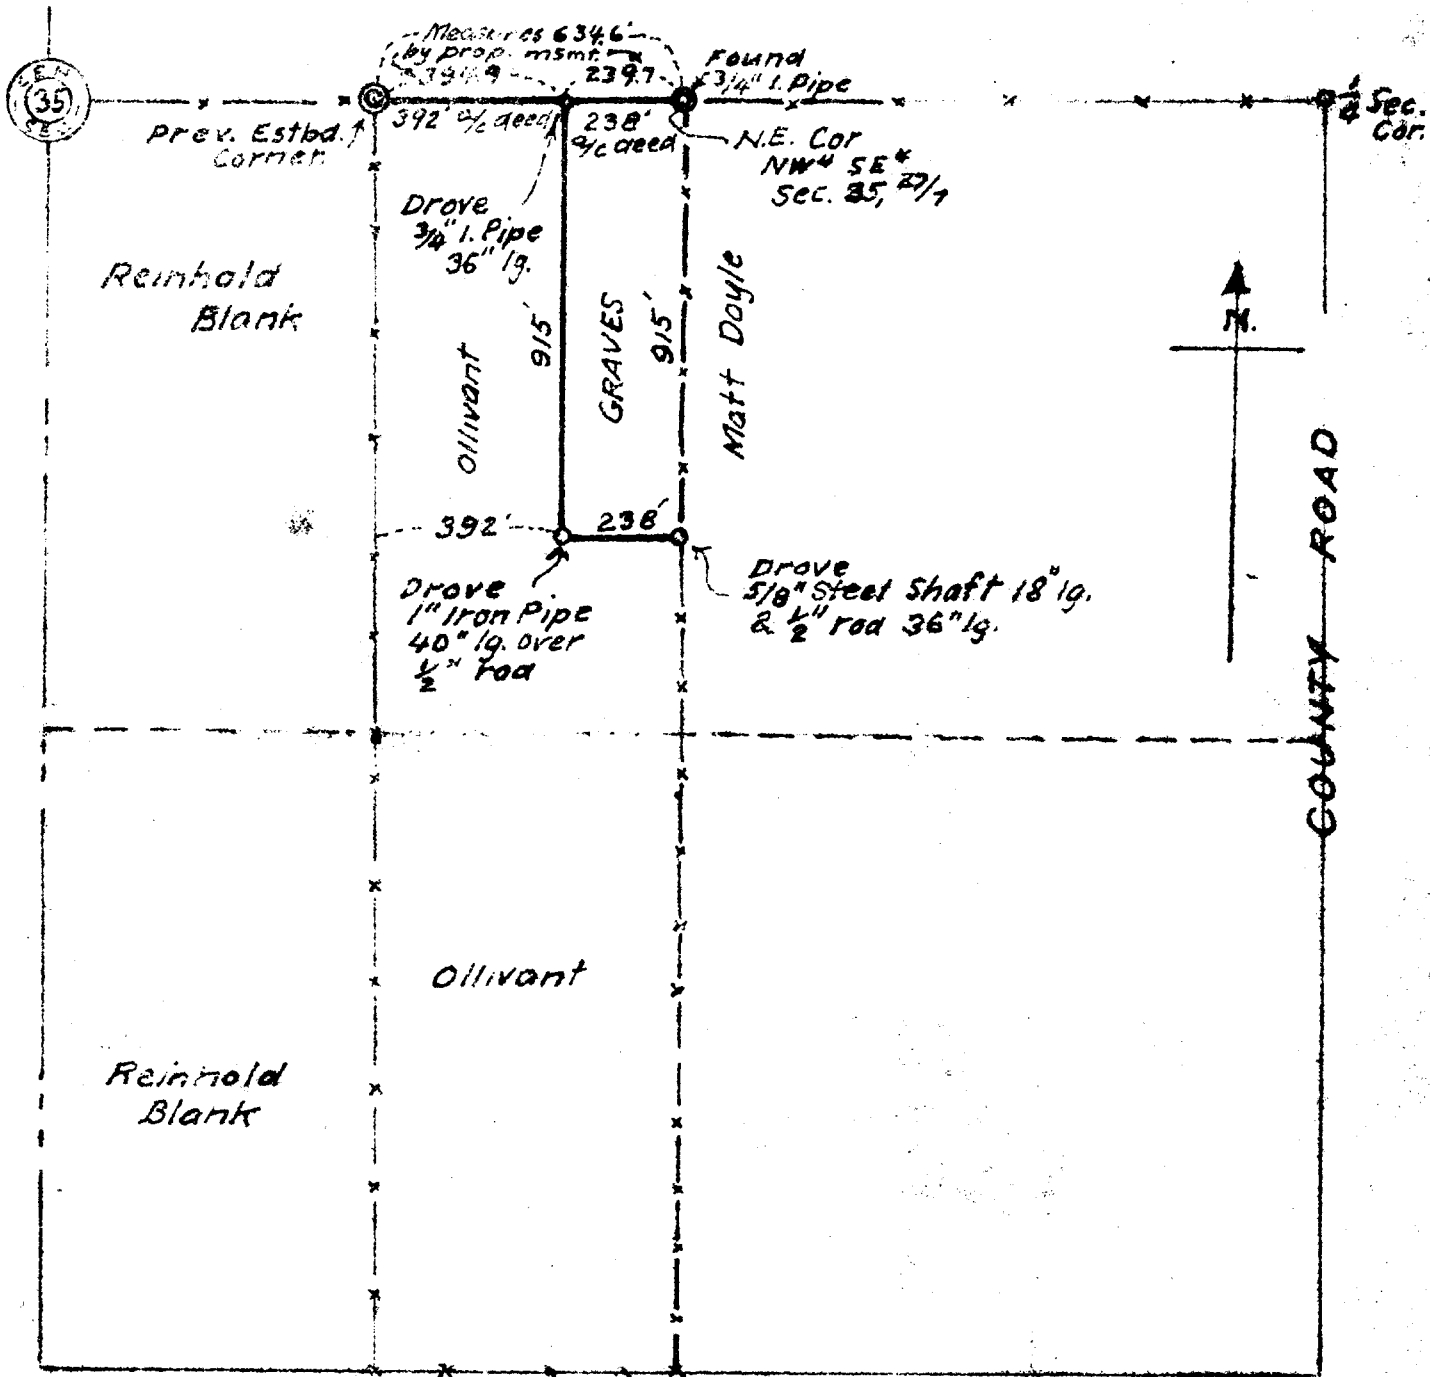

Mrs Graves  
 Matt Doyle  
 E. E. Ollivant  
 Alfred "  
 Harvey Epst'n  
 A Boyer

COUNTY SURVEYORS FILE DATA  
 DO NOT REMOVE FROM OFFICE

FILED  
 RECEIVED

JUN 20 1961

COUNTY SURVEYOR  
 DOUGLAS COUNTY, ORE.

ALFRED OLLIVANT  
 PORTION OF ACREAGE  
 ADJACENT TO BOB GRAVES  
 IN NW 4 SE 1/4 Sec. 35 T21S, R7N, W1E  
 LOOKING GLOSE VALLEY  
 JAN 1961

CS 51/326

C.S. No. 51/326