

T. 42 N. R. 11 E. SW 1/4 SEC. 3

**SURVEY OF LOTS 12, 13 AND 14, BLOCK 45,
REEDSPORT ADDITION TO REEDSPORT,
DOUGLAS COUNTY, OREGON**

**COUNTY SURVEYOR TIT II
DO NOT REMOVE FROM OFFICE**

for



RALPH PAULL

Scale: 1" = 100'

Corners found: ● 1/2" iron pipe

Corners set: ○ 3/4" iron pipe

March 30, 1962

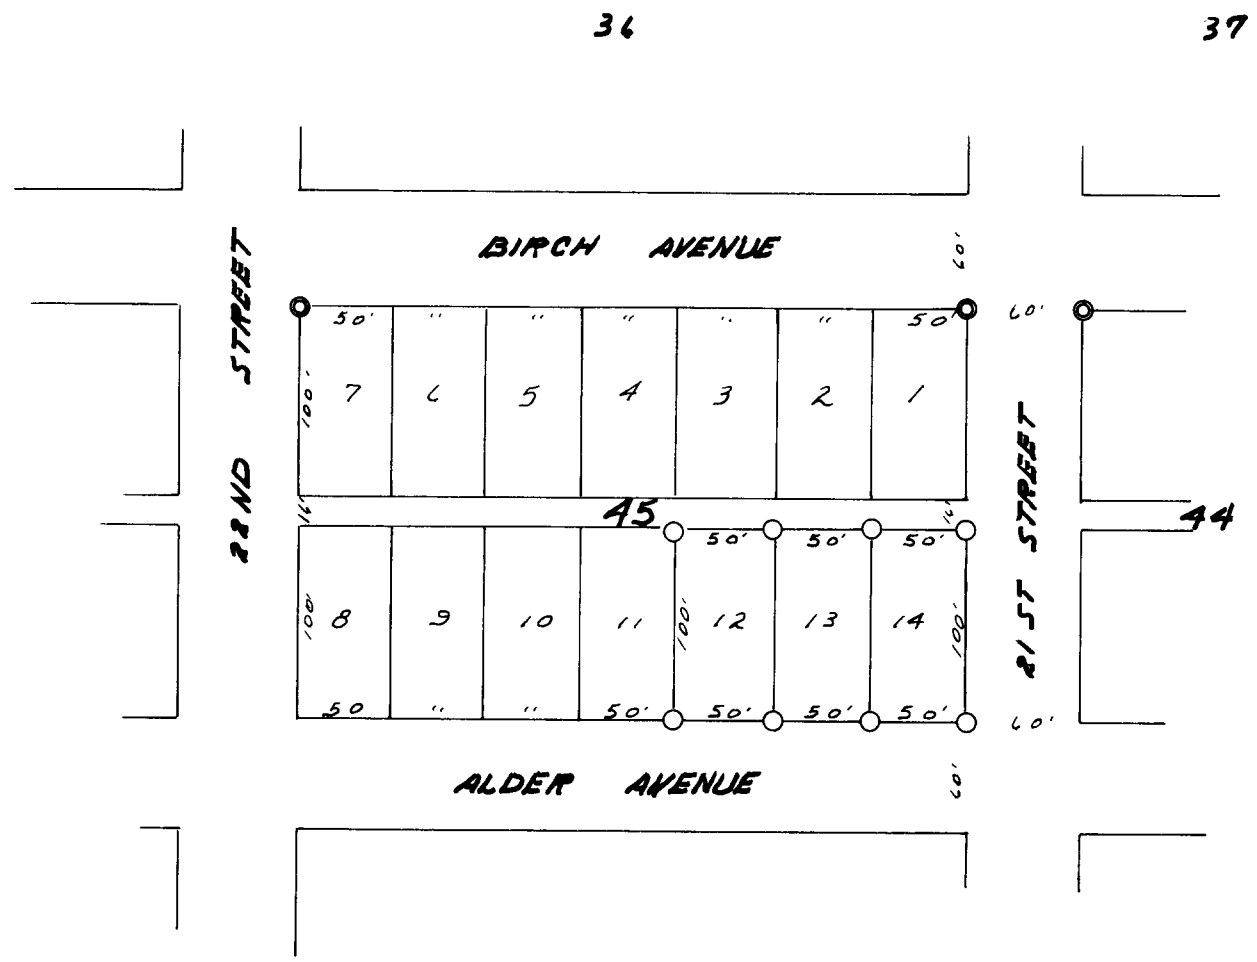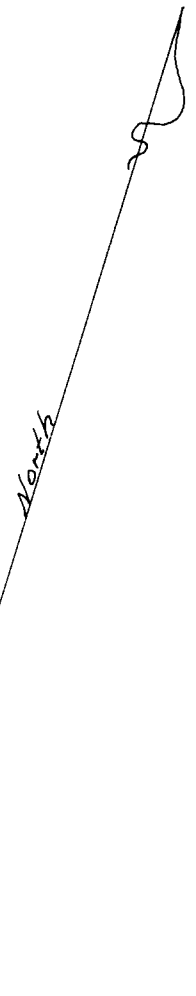

FILED *L.L.*
RECEIVED

JUL 30 1962

COUNTY SURVEYOR
DOUGLAS COUNTY, ORE.

Warren A. Foster
MAY 10 1962
WARREN A. FOSTER
COUNTY SURVEYOR
DOUGLAS COUNTY, ORE.