

T. 22 S. R. 12 W. NW NW 1/4 SEC 3



**SURVEY OF LOT 13, BLOCK 7,
REEDSPORT ADDITION TO REEDSPORT,
DOUGLAS COUNTY, OREGON**

for
RALPH PAULL

**COUNTY SURVEYORS FILE DATA
SHOULD BE REMOVED FROM OFFICE**

Scale: 1" = 100'
Corners found: \odot 1/2" iron pipe
Corners set: \circ 3/4" iron pipe

March 30, 1962

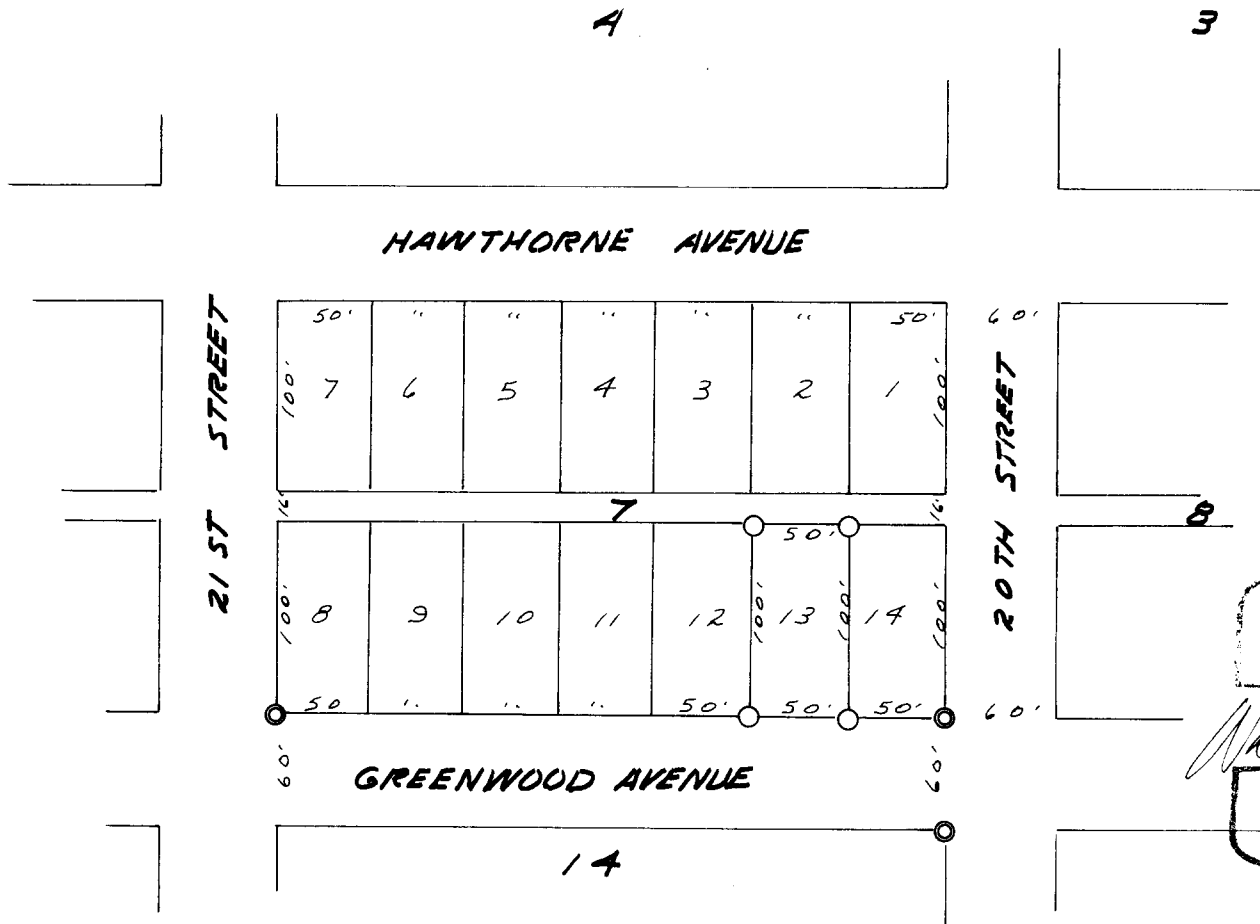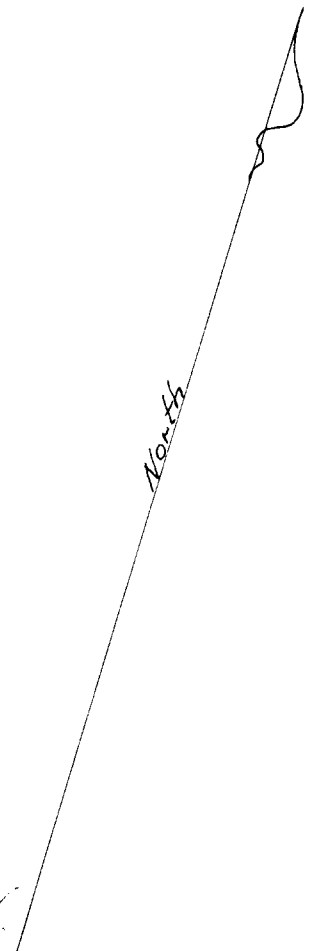

FILED
RECEIVED

JUL 30 1962

COUNTY SURVEYOR
DOUGLAS COUNTY, ORE.

REGISTERED
COUNTY SURVEYOR
Warren D. Footman
MAY 20 1957
WARREN D. FOOTMAN
309