

SURVEY IN DO NOT REMOVE FROM OFFICE

SECTION 22, T 26 S, R 4 W, W.M.

SURVEYED FOR: C. H. BILLETER

MAY, 1962

SURVEYED BY: G. R. LECKLIDER-ENG'R.

SCALE: 1" = 30'

Fd. Brass cap & 3 BT's set for the sector corner of sections 14, 15, 22 & 23.

N 16° 47' E - 652.60'

COUNTY ROAD No. 48

SET 3/4" Iron rod

N 89° 23' E - 750.80'



West line M. Peevly D.L.C. No. 41  
NORTH - 2094.60'

36.46 ACRES

S 00° 26' E - 2104.20'

N 89° 54' W - 766.90

SET: 3/4" Iron rod from which  
A 12" Oak - N 40° E - 7.1' (mkd "CHB") BT  
A 10" Oak - S 4° W - 6.5' (mkd "CHB") BT

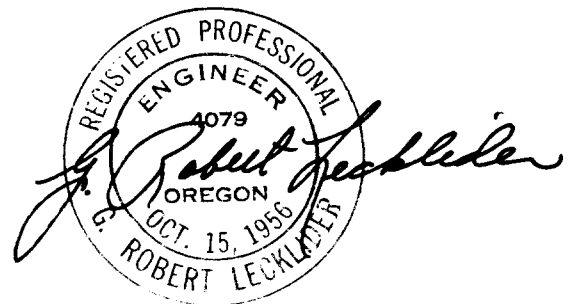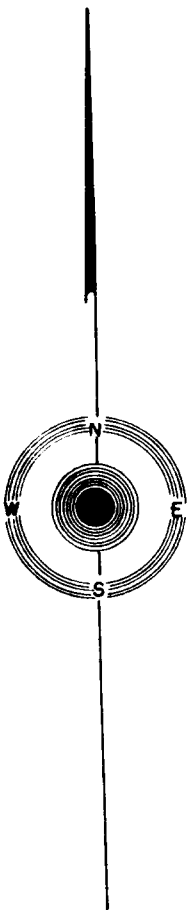

FILED L.L.  
RECEIVED

MAY 14 1962

COUNTY SURVEYOR  
DOUGLAS COUNTY, ORE.