

FORESTRY DEPT. PROPERTY

N 0°-22'W 942.73'

GUY GILL PARCEL

1/2" Iron Pins Set on all corners

S 0°-52'E 844.77'



TODD BUILDING COMPANY

FLAGG STREET 50'


SUBDIVISION NO. 1

A PORTION OF LOT 24 - 1ST BROOKSIDE

FILED RECEIVED

APR 25 1962

COUNTY SURVEYOR DOUGLAS COUNTY, ORE.

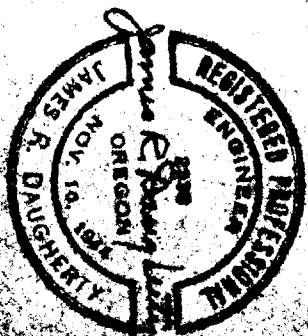

MAY 31, 1956

COUNTY SURVEYORS FILE DATA
DO NOT REMOVE FROM OFFICE
SURVEYED BY JAMES R. DAUGHERTY
CIVIL-SANITARY ENGINEER
ROSEBURG, ORE.

SCALE 1" = 100'

PARCEL IN LOTS 23 & 24 - 1ST ADDITION OF BROOKSIDE

DIAMOND LAKE BLVD. 80'

Surveyed For GUY GILL

S 89°-44'E 204.4'

351.8'

LOT 24 = 764' = 462'

LOT 23 396'

N.E. Cor. Lot 24 1ST BROOKSIDE

SECTION 20 T 27 S. R 5 W. W. M. DOUGLAS COUNTY OREGON

E. DOUGLAS ST. 60'

Axle S.W. Con Lot 23

152.75'

S 50°-52'E

100'

60'

100'

N 89°-17'W 212.75'

30'