

NW CORNER
ALPH. IRELAND
D.L.C. #47

SOUTH
631.7

TIE BY DEED
COUNTY

EAST ~ 3249.7


S 71°-45' W
128.5

ROAD NO. 18

N 83°-30' W ~ 510.0

COUNTY SURVEYORS FILE DATA
DO NOT REMOVE FROM OFFICE

• SET 3/4" IRON PIPE

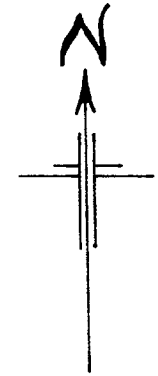

FILED
RECEIVED

MAY 31 1962

COUNTY SURVEYOR
DOUGLAS COUNTY, ORE.

Donald R. Weston

9.6 ACRES

SOUTH MYRTLE

S 23°-45' W ~ 680.0
735.0

S 14°-43' W
79.0

S 31°-46' E
596.2

S 65°-00' E ~ 332.0
564.01 E
98.0

N 62°-26' E
186.5

N 58°-00' E ~ 425.0

N 70°-43' E ~ 224.0

FOUND 1" IRON PIPE

108.0

CREEK

FIELD SURVEY & PLAT FOR
WALTER M. MEYER
MYRTLE CREEK, OREGON

ALPHEUS IRELAND D.L.C. #47 ~ SEC. 23 & 26 T29S R5W W.M. DOUGLAS COUNTY

SCALE: 1 IN = 100 FT.

MARTIN ENGINEERING SERVICE ~ MYRTLE CREEK, OREGON

APRIL 1962

51/2374