



LOT 4, 5 & 6 BK. 2 J. THOMAS KERR TRACTS

COUNTY SURVEYORS FILE DATA
DO NOT REMOVE FROM OFFICE

DOUGLAS COUNTY, OREGON

Steve Ferche'


MEADOW LANE - 60 ft.

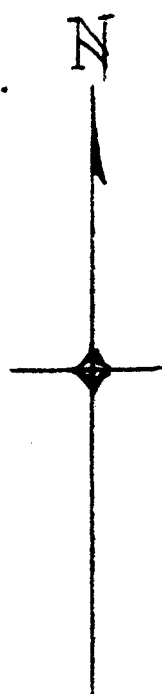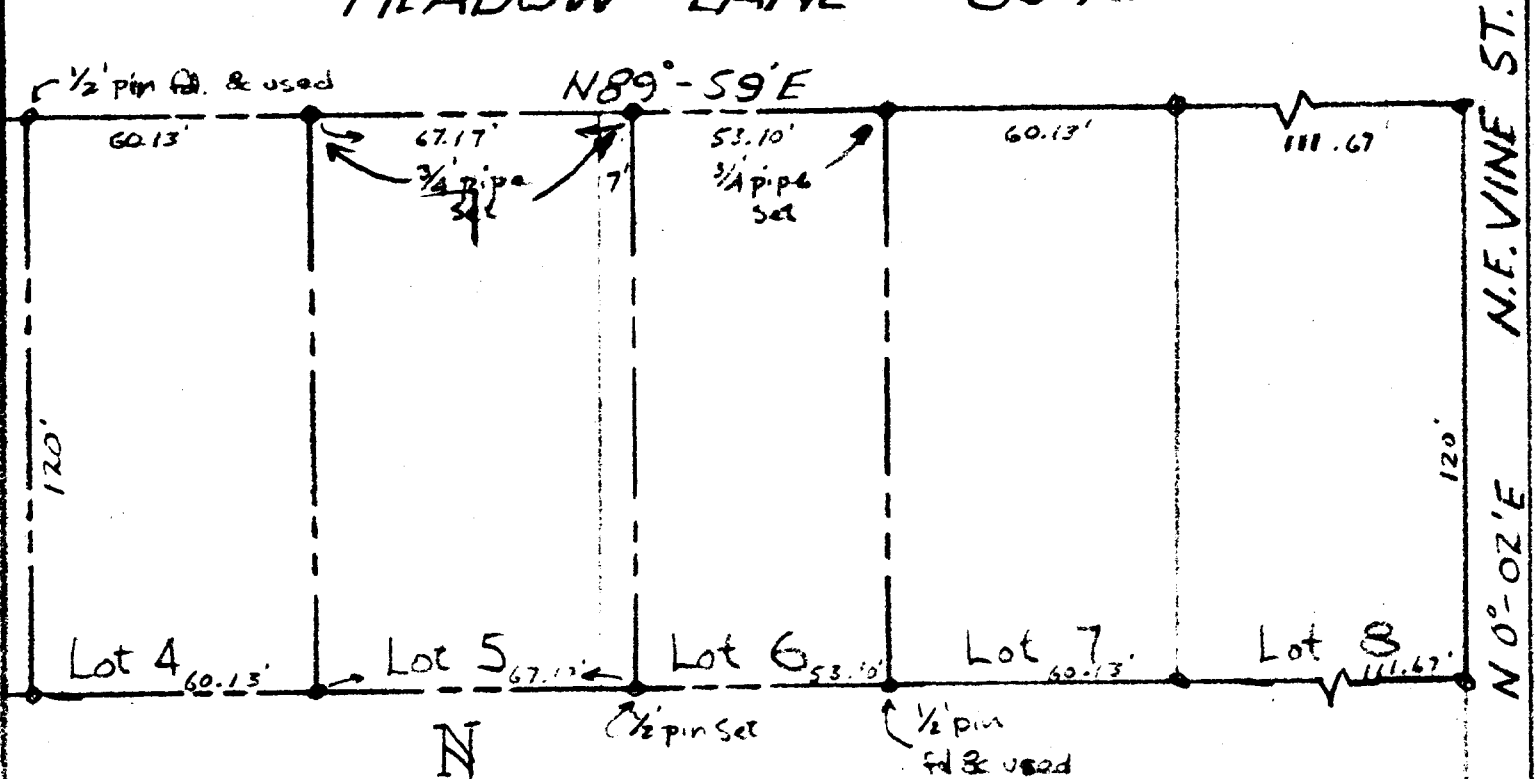

FILED *L.L.*
RECEIVED

AUG 2 1962

COUNTY SURVEYOR
DOUGLAS COUNTY, ORE.

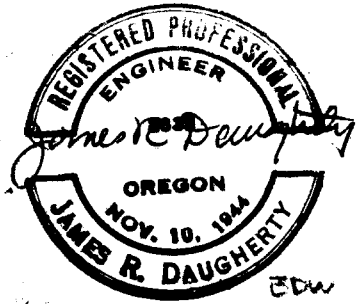

Scale 1" = 40'
July 30, 1962

WALTER B. ...
CIVIL ENGINEER
WINSTON, OREGON

C.S. File No. 51/24 BT & 4