

FILED *L.L.* COUNTY SURVEYORS FILE DATA  
RECEIVED DO NOT REMOVE FROM OFFICE

*B.N.* AUG 23 1962

COUNTY SURVEYOR  
DOUGLAS COUNTY, ORE.

$S 89^{\circ} 41' E$  SOUTH LINE D.L.C. #54

2,632.01'

878.0'

$\frac{3}{4}$  in. pipe Set

POWELL 5.051 Ac.

Total 6.00 Ac

$S 89^{\circ} 41' E$   
517.3'

FREDRICK W. LEVIN  
2.0 Acres  $\pm$

0.949 Ac.

0.421 Acres  
276 ft.

Set 1" Iron Bar

311.3'  
 $N 89^{\circ} 41' W$

DONALD COLWELL

S.E. Cor. Lot 4

Set  $\frac{3}{4}$  pipe

Fred W. Levin

DOUGLAS COUNTY OREGON  
Z.E. 3, 3325 3

M 61-905

PARCELS IN LOT 4 - SECT. 32 - T27S - R7W - WM.

S.W. COR. D.L.C. #54  
 $\frac{3}{4}$  in. pipe fd.

2000.0'

$N 0^{\circ} 19' E$   
 $\frac{1}{2}$  I.P. Set

91.8'

Roadway Easement

$N 53^{\circ} 41' W$

200.0'

$N 87^{\circ} 41' W$


$\frac{1}{2}$  Pipe Set

100.0'

$N 34^{\circ} 41' W$

1 in. Steel Bar Set

S. R. DAUGHERTY  
CIVIL-SANITARY ENGINEER  
WINSTON, OREGON

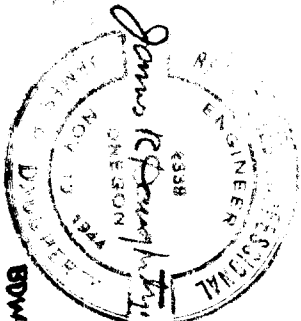

REV July 23, 1962

Scale 1"=100'