


COUNTY SURVEYORS FILE DATA
DO NOT REMOVE FROM OFFICE



7. 22. 1962
SURVEY OF LOTS 12, 13 AND 14, BLOCK 19,
REEDSPORT ADDITION TO REEDSPORT
DOUGLAS COUNTY, OREGON

for
HEINZ KAUFMANN

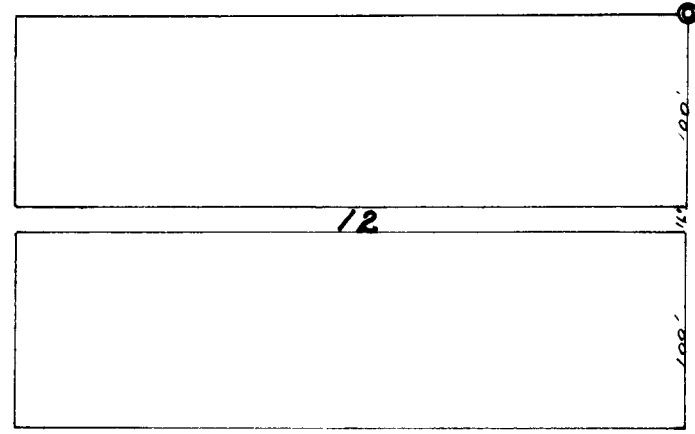


FIR AVENUE

18 IN STREET

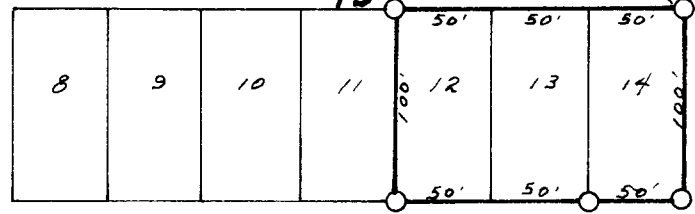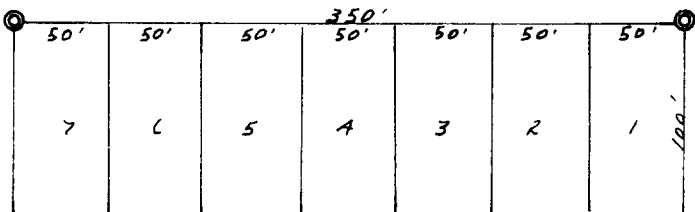

WINCHESTER AVENUE

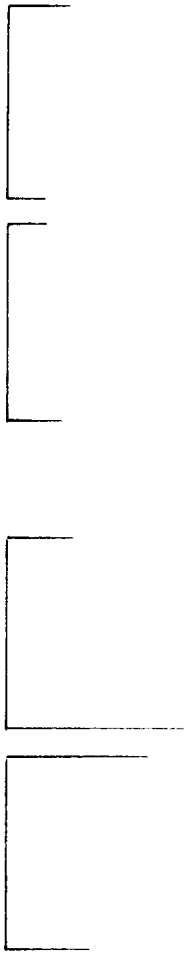

North



FILED
RECEIVED

FEB 25 1963

COUNTY SURVEYOR
DOUGLAS COUNTY, ORE.

September 22, 1962
Scale: 1" = 100'
Corners found: ● 3/4" pipe
Corners set: ○ 3/4" pipe