
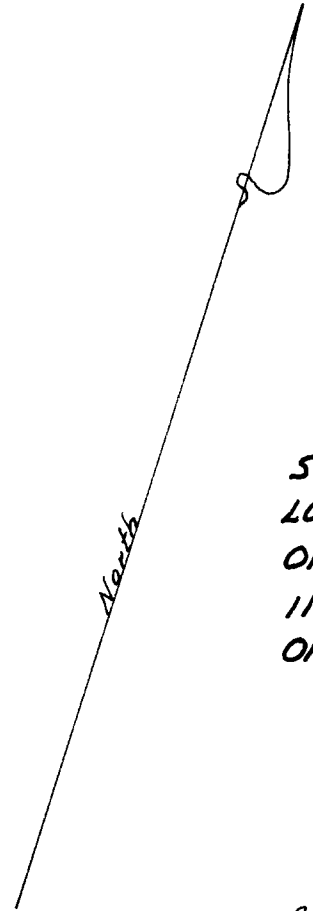


COUNTY SURVEYORS FILE DATA
 DO NOT REMOVE FROM OFFICE

C.S. No. 51/2437A

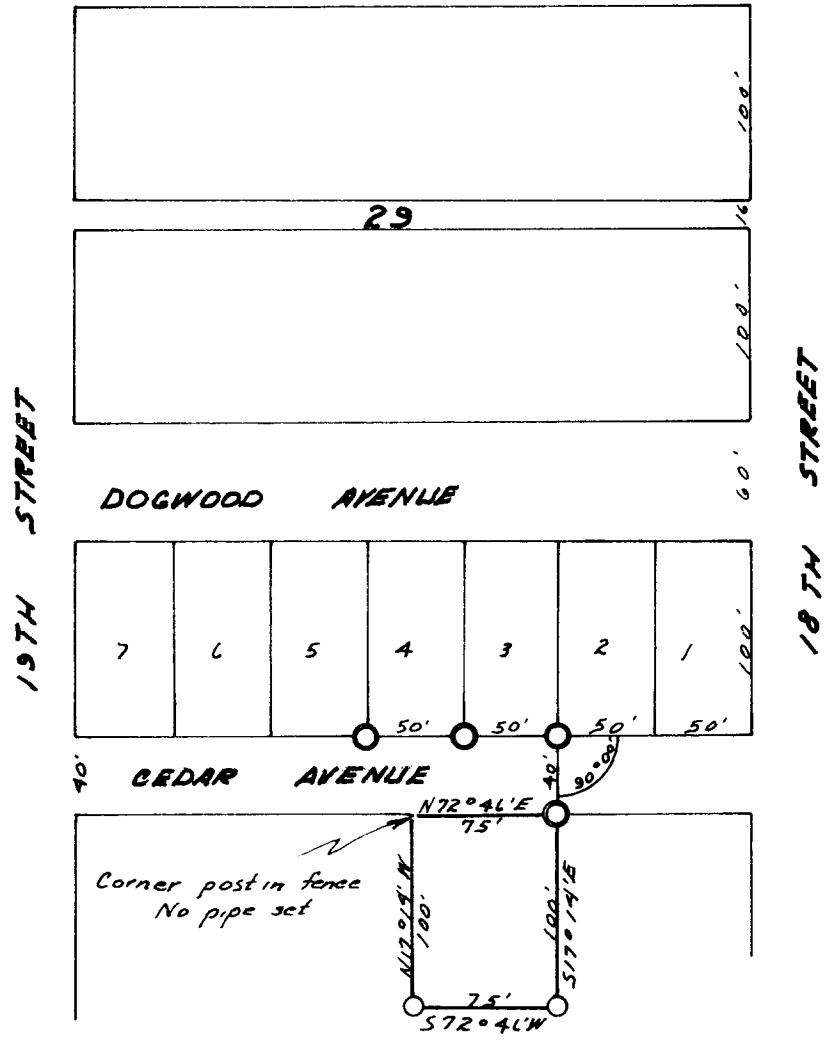

T 20 S R 12 W M 10 W 2 S
 SURVEY OF PROPERTY BEING PARTS OF
 LOTS 11 AND 12, BLOCK 32, AND A PORTION
 OF CEDAR AVENUE WHICH INURED TO LOTS
 11 AND 12 OF SAID BLOCK UPON VACATION
 OF BLOCK 32, REEDSPORT, DOUGLAS COUNTY, ORE.

for
 LEROY NELSON

Corners found: \bigcirc $\frac{3}{4}$ " pipe June 1, 1963
 Corners set: \bigcirc $\frac{3}{4}$ " pipe
 Scale: 1" = 100'
 Basis of bearing: Pipes found on north line of relocated
 Cedar Avenue.

FILED *FL*
 RECEIVED

JUN 5 1963

COUNTY SURVEYOR
 DOUGLAS COUNTY, ORE.

REGISTERED
 OREGON
 LAND SURVEYOR
Warren D. Rootman
 MAY 10 1963
 WARREN D. ROOTMAN
 390

33
 CEDAR