


FILED  
RECEIVED

L. L.

**COUNTY SURVEYORS FILE DATA  
DO NOT REMOVE FROM OFFICE**

MAR 6 1963

COUNTY SURVEYOR  
DOUGLAS COUNTY, ORE.

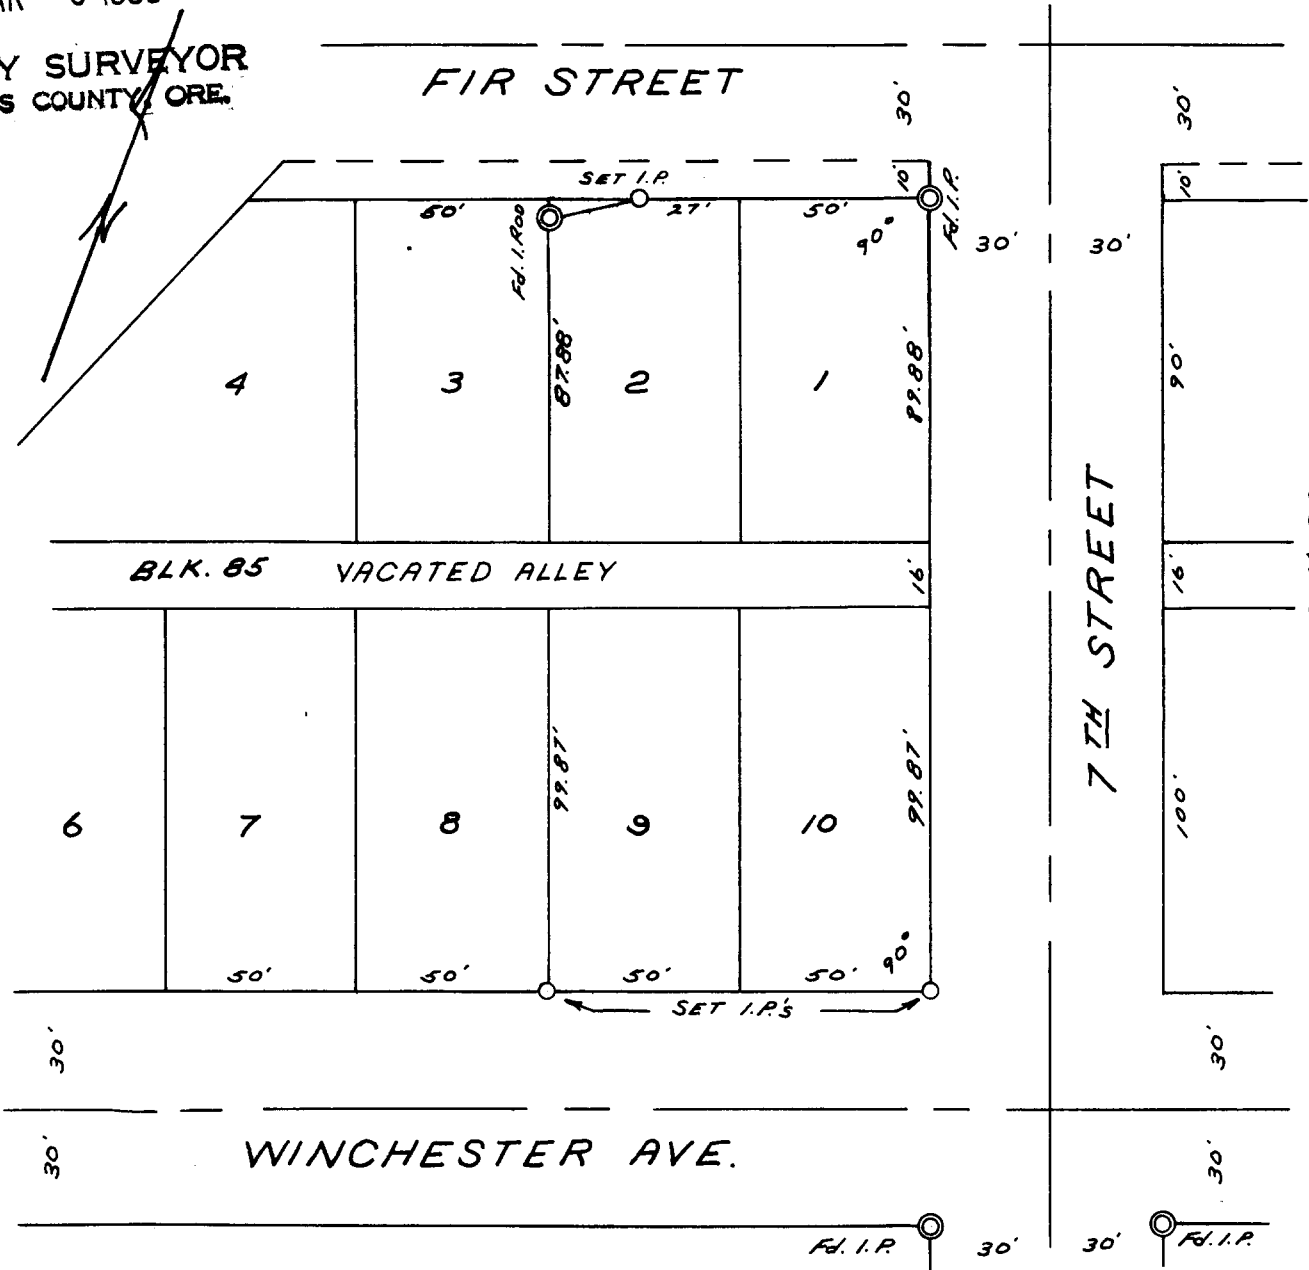

REGISTERED  
**OREGON**  
LAND SURVEYOR

*Richard J. Hintz*

MAY 13, 1960  
RICHARD J. HINTZ  
497

PROPERTY SURVEY  
FOR  
DR. JASON BOE

LOTS 1, 2, 9, 10 & VACATED ALLEY; BLK. 85  
RAILROAD ADDITION TO REEDSPORT  
DOUGLAS COUNTY, OREGON  
JAN. 2, 1963 SCALE: 1" = 50'

T.21 S. R. 12 W. SW SW 1/4 Sec. 35  
C. S. File No. 51/252-#