
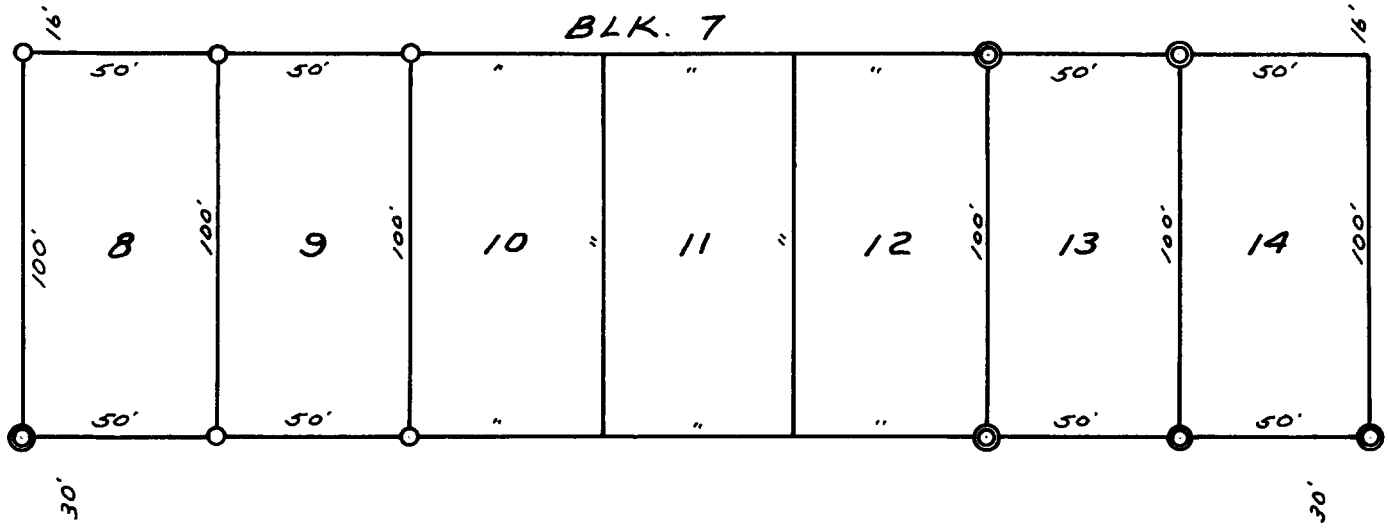


RECORDS SECTION  
COUNTY CLERK'S OFFICE  
RECORDS SECTION  
COUNTY CLERK'S OFFICE

NORTH 21<sup>ST</sup> STREET

NORTH 20<sup>TH</sup> STREET

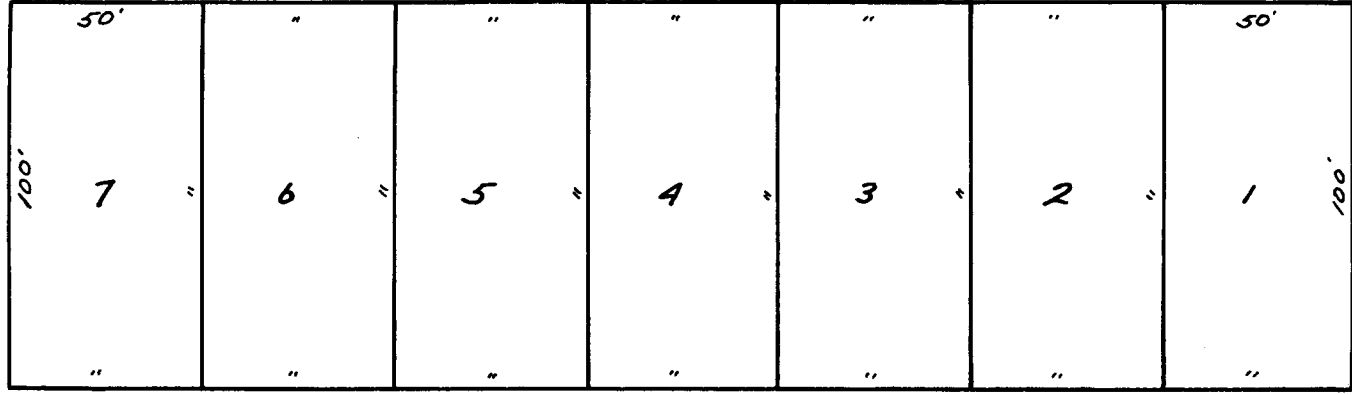

GREENWOOD AVENUE

REGISTERED  
OREGON  
LAND SURVEYOR

*Richard J. Hintz*

MAY 13, 1960  
RICHARD J. HINTZ  
497

PROPERTY SURVEY  
FOR  
GRANT DUNN

LOTS 8 & 9, BLK. 7; REEDSPORT ~~ADD'L~~  
TO CITY OF REEDSPORT  
DOUGLAS COUNTY, OREGON  
MAY 2, 1963 SCALE: 1" = 50'

© 0  
I.P.S. FOUND  
I.P.S. SET

FILED  
RECEIVED

JUL 26 1963

COUNTY SURVEYOR  
DOUGLAS COUNTY, ORE.