


COUNTY SURVEYORS FILE DATA
DO NOT REMOVE FROM OFFICE

FILED
RECEIVED
JUN 2 1964

COUNTY SURVEYOR
DOUGLAS COUNTY, ORE.

NORTH

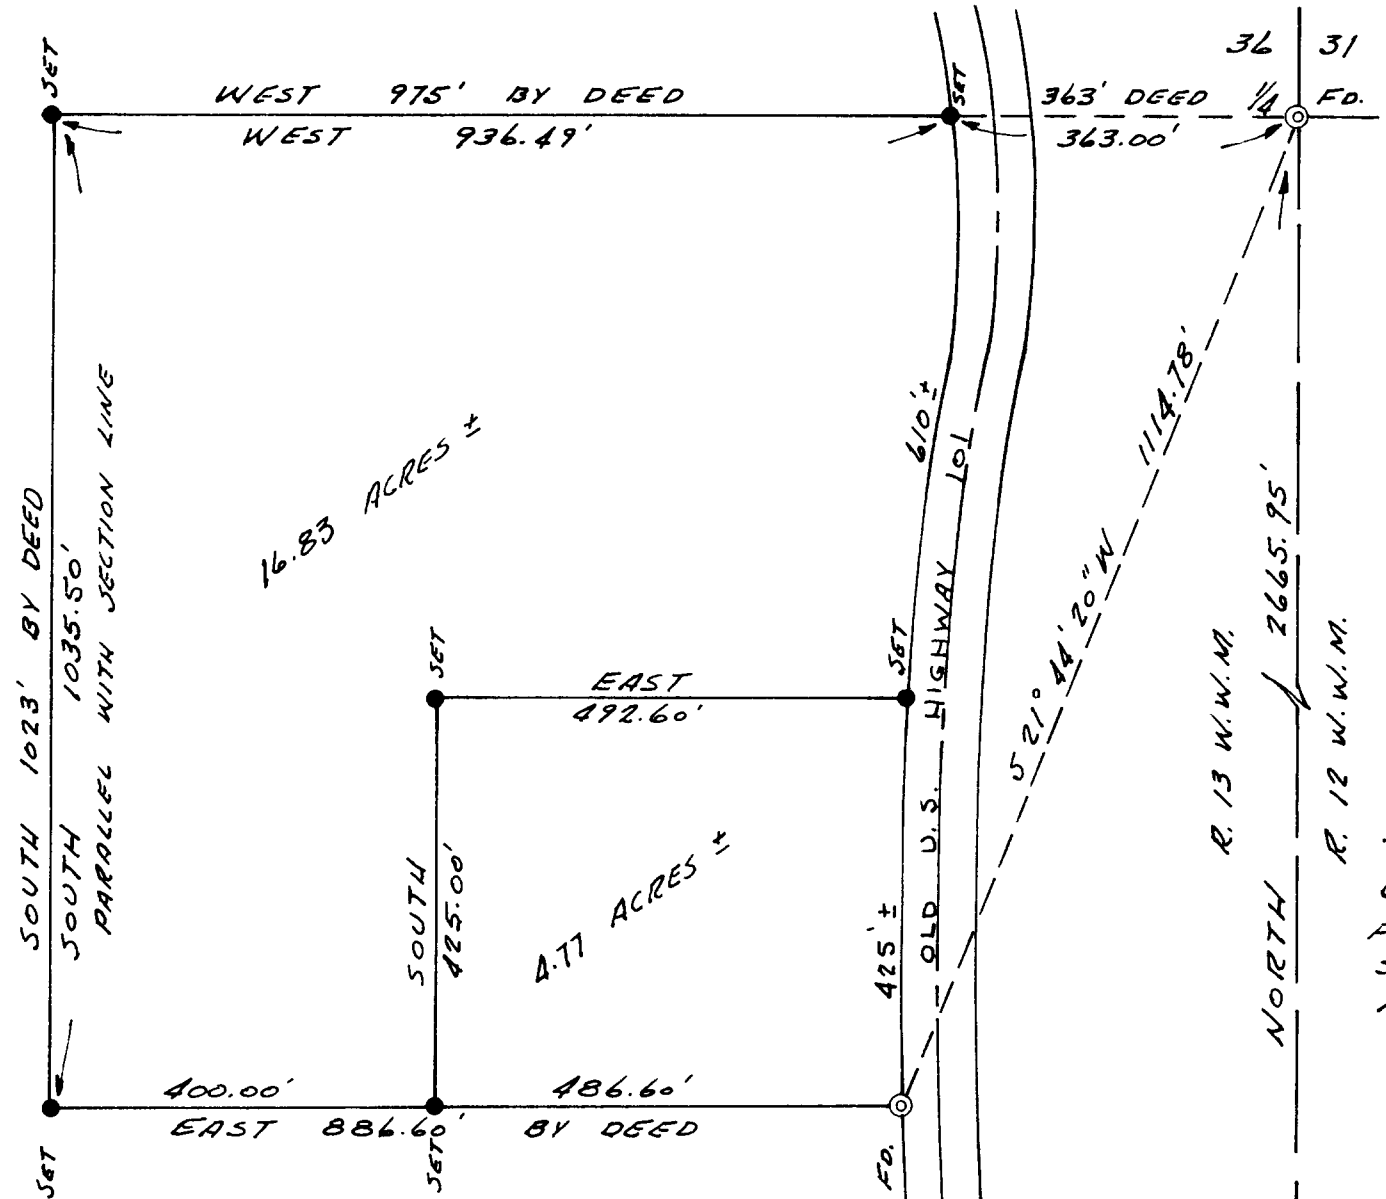

NOTE: SOUTH LINE & S.E. I.P. USED
& ACCEPTED AS PER PREVIOUS
SURVEY BY W.J. BRAYTON - FEB. 21, 1955

PROPERTY SURVEYS
IN SECTION 36
T. 22 S., R. 13 W.W.M.
DOUGLAS COUNTY, OREGON
FOR JEFF LIGHTFOOT
SCALE: 1"=200' 12-21-63
R.H. ERICHSEN & ASSOCIATES
COOS BAY, OREGON

T. 22 S. 36
T. 23 S. 1

