

Shaner's Engineering & Surveying

ROAD ENGINEERING & LAND SURVEYING
1717 S.W. McLAIN
ROSEBURG, OREGON 97470

Aug. 24, 1964

LEGAL CORNER RESTORED FOR U.S. FOREST SERVICE

1/4 Section Corner common to Sections 16 & 21, T28S, RLW, W.M., Douglas County, Oregon, found Basalt Stone, from which a:

18" Douglas Fir Bearing Tree with scribes visible bears S15°W, 9.9 feet.

18" Douglas Fir Bearing Tree with old face bears N50°E, 6.6 feet.

16" Douglas Fir Bearing Tree, I scribed "1/4 S S21 BT", bears S26°E, 84.0 feet. ✓+

LEGAL CORNER FOUND FOR U.S. FOREST SERVICE

1/4 Section Corner common to Sections 16 & 17, T28S, RLW, W.M., Douglas County, Oregon, found Basalt Stone with "4" still visible, from which stone a:

24" Douglas Fir Bearing Tree with scribes visible bears S75°W, 31.7 feet.

24" Douglas Fir Bearing Tree with old face bears S74°E, 42.2 feet. ✓



Copies: Douglas County Surveyor
U.S. Forest Service, S. Umpqua District

FILED
RECEIVED

AUG 26 1964

COUNTY SURVEYOR
DOUGLAS COUNTY, ORE.

LEGAL CORNERS RESTORED FOR UMPQUA NATIONAL FOREST IN T28S, RLW, W.M.

Section Corner common to Sections 26, 27, 34 & 35, T28S, RLW, found original basalt stone, from which a:

16" D. Fir, original bearing tree with old face, bears N58°E a distance of 27.7 ft. (Record 29.0 ft.)

D. Fir, original bearing tree, now blown down, bears SE, 16.5 ft..

16" Hemlock, original bearing tree with scribes visible, bears S24½°W, 27.7 ft. (record 29.0 ft.).

Hemlock, original bearing tree, now blown down, bears N82°W, 29.0 ft..

6" Yew, I scribed "S35 BT", bears S75°E, 5.0 ft..

8" Hemlock, I scribed "S27 BT", bears N43½°W, 12.0 ft..

+ O

Section Corner common to Sections 22, 23, 26, & 27, T28S, RLW, found original basalt stone, from which a:

26" D. Fir bearing tree with old face bears N62°E, 32.0 ft..

24" Incense Cedar bearing tree with scribes visible bears S5°E, 33.5 ft..

12" D. Fir bearing tree with scribes visible, now blown down, bears SW, 10 ft..

36" D. Fir bearing tree, now blown down, bears NE, 45 ft..

12" D. Fir, I Scribed "S27 BT", bears S81°W, 23.0 ft..

38" D. Fir, I scribed "T28S, RLW, S22, BT", bears N52°W, 65.4 ft..

+ O

Quarter Section Corner common to Sections 14 & 23, T28S, RLW, found original basalt stone, from which a:

34" D. Fir, original bearing tree with old face, bears S51°E a distance of 43.0 ft.. (Record is SE, 44.9 ft..)

24" D. Fir, original bearing tree with old face, bears N15°W a distance of 7.9 ft..

+ O


Above restorations filed with Douglas County Surveyor, July 15, 1963.

FILED *LL*
RECEIVED

JUL 16 1963

COUNTY SURVEYOR
DOUGLAS COUNTY, ORE.

+

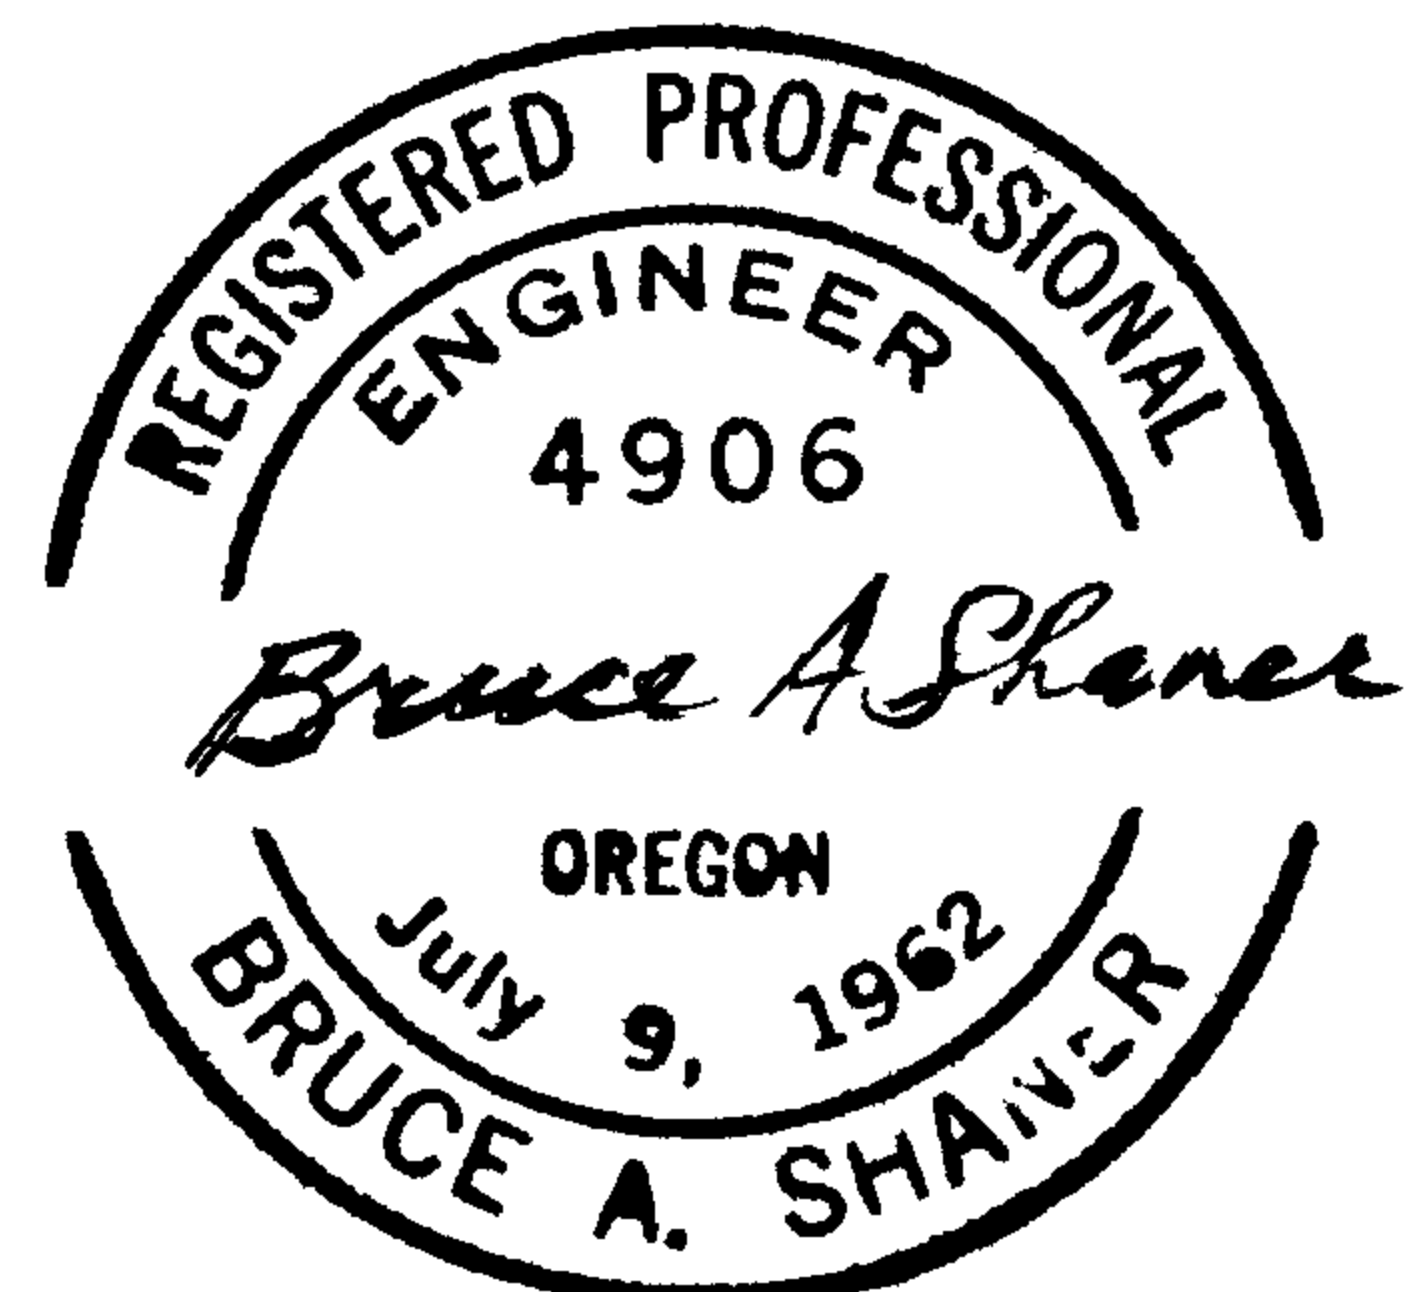

C. S. File No. 51/259