

REWITNESSED CORNER (Reported by State of Oregon-Department of Forestry)

One quarter corner common to Sections 34 and 3, T21 & 22S, R11W, W.M., Douglas County, Oregon.

ORIGINAL

Post (missing, found 1 $\frac{1}{4}$ " iron pipe with cap in place) from which a:

- 12" Spruce bears N34 $\frac{1}{2}$ W 36 lks.; now badly rotted uproot.
- 30" Spruce bears S31 $\frac{1}{2}$ E 72 lks.; now 60" , original face grown over (see restoration by Hootman below).

REWITNESSED by W. Hootman (no record found) from which a:


- 60" (orig. 30") Spruce bears S31 $\frac{1}{2}$ E 72 lks.; scribes BT $\frac{1}{4}$ S3 T22 399 visible in new face 5 or 6 years old.
- 24" double Spruce bears N68E 15.9 ft.; scribes $\frac{1}{4}$ S34 T21 visible.

Note: added scribes RS359 on 24" Spruce.

4 x 4 Elliott survey post 6 in. West of corner pipe.
Oregon State Forestry Department metal location poster on original 30" Spruce.

Dated January 16, 1964

Present and witnessed by T. Paterson

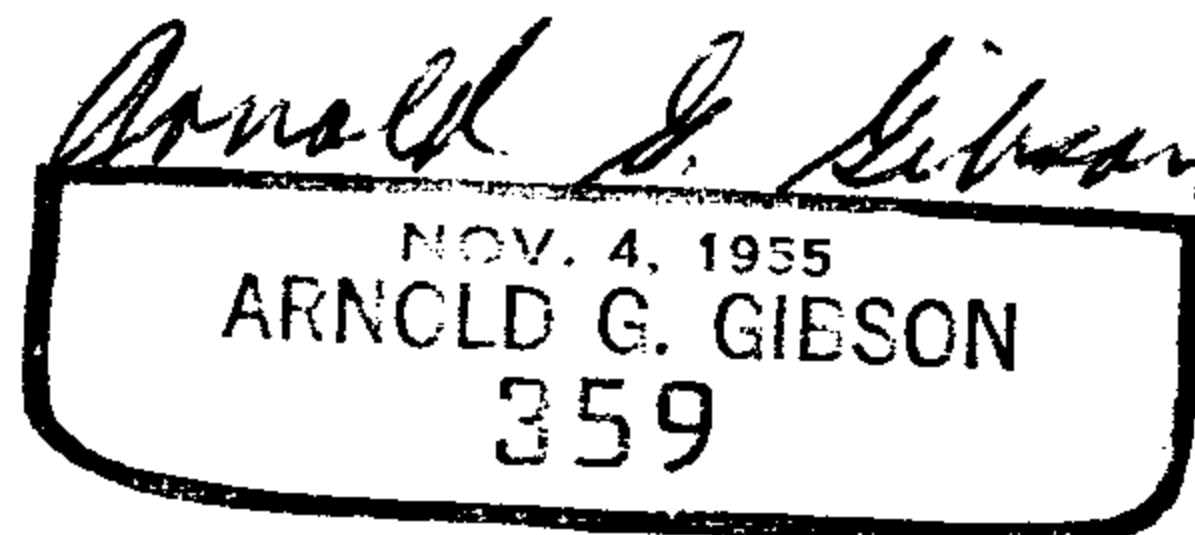

FILED
RECEIVED

FEB 4 1964

COUNTY SURVEYOR
DOUGLAS COUNTY, ORE.

U.S. File 51 / 260-2

M 27 - 28

RESTORED CORNER FOR STATE OF OREGON-DEPARTMENT OF FORESTRY

Section corner common to Sections 2 and 11 (West end)
T22S, R11W, W.M., Douglas County, Oregon.

ORIGINAL

Stone 16 x 12 x 12 (found in place marked CC and 2 notches East, 5 notches South) from which a:

- 3" Willow bears N28½E 44 lks.; now missing.
- 40" Burnt Fir bears S78E 151 lks.; now 6' stub in place.

RESTORATION by W. Haines 1956

Lot Marker (no marker or rod found) from which a:

- 16" Fir bears S20E 8.2 ft.; in place.
- 30" Fir bears N72½E 29.3 ft.; in place.

RESTORED

Set 1½" x 36" galvanized iron pipe with 3" bronze cap marked "OREGON STATE BOARD OF FORESTRY T22S R11W CC S2 S11 1963 RS 359", 36 inches in ground, alongside east side of original corner stone in mound of rock, and from which a:

26" Fir bears N74W 8.6 ft.; scribed RS359.

4 x 4 Elliott survey Cedar post 3.0 ft. SE of corner stone.
Oregon State Forestry Department metal location poster on above 26" Fir.

Dated January 16, 1964.

Restored by



Present and witnessed by T. Paterson

U.S. File.....51/260²

Map File M27+28