

RESTORED CORNER FOR STATE OF OREGON-DEPARTMENT OF FORESTRY

One quarter corner common to Sections 20 and 29, T22S,
R11W, W.M., Douglas County, Oregon.

ORIGINAL

12 x 10 x 6 stone (found in place $\frac{1}{4}$ on West side) from which a:

6" Fir bears S4E 59 lks.; now 22" dead fir, face grown over.
5" Chittum bears N42E 37 lks.; now 5" uproot, badly rotted.
Dry Creek, course N20E, West 66.0 ft.; in place.

RESTORED


Set $1\frac{1}{2}$ " x 36" galvanized iron pipe with 3" bronze cap marked "OREGON
STATE BOARD OF FORESTRY $\frac{1}{4}$ S20 S29 1963 RS359", 30 inches in
ground, with original corner stone on N side in small mound of
rock, and from which a:

18" Cedar bears N64E 85.5 ft.; scribed $\frac{1}{4}$ S20 BT RS359.
12 ft. high rock bluff (extending to 40 ft. high at 200 ft. South)
bears S13W 30.3 ft.; scribed XBO.
Mouth of dry gully from West joins creek at N38W 90. ft.

Set 4 x 4 x 72" white painted Cedar post 2.0 ft. SW of corner pipe.
Oregon State Forestry Department metal location poster on 25" Alder
N77E 33.2 ft.

Dated January 16, 1964.

Restored by

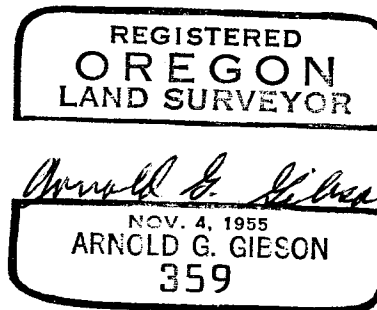

Present and witnessed by D. Mallery
P. Lewellyn
G. Gresham

FILED
RECEIVED

FEB 4 1964

COUNTY SURVEYOR
DOUGLAS COUNTY, ORE.

C.S. File 51/260-3

File