

RESTORED CORNER FOR STATE OF OREGON-DEPARTMENT OF FORESTRY

Section corner common to Sections 14 and 15 (North end)
T.22S, R.11W, W.M., Douglas County, Oregon.

ORIGINAL

Stone 16" x 12" x 10" in stone mound (found in place on top of ridge, notches weathered and indistinct, 3.93 chains East of Sec. corner 10 and 11).

RESTORATION by 1941 Elliott Survey.

14" Fir bears S55°W 18 lks.; now 20", blaze grown over, uprooted to the north.

RESTORED

Set 4 x 4 x 72" white painted Cedar post 2.0 ft. SW of corner stone, from which a:

17" Fir bears S37 $\frac{1}{2}$ °W 20.0 ft.; scribed T22S R11W S15 BT.


14" Fir bears S82 $\frac{1}{2}$ °E 48.7 ft.; scribed T22S R11W S14 BT RS359.

Oregon State Forestry Department metal location poster on 17" Fir BT.

Dated Nov. 14, 1963



Restored by

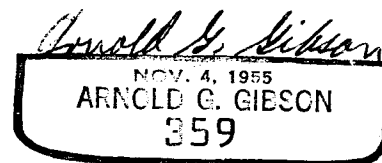

Present and witnessed by P. Lewellyn

FILED
RECEIVED

NOV 26 1963

COUNTY SURVEYOR
DOUGLAS COUNTY, ORE.

C. S. File No. 51/262-6

#58