

RESTORED CORNER FOR STATE OF OREGON-DEPARTMENT OF FORESTRY

One quarter corner common to Sections 15 and 22, T.22S,  
R.11W, W.M., Douglas County, Oregon.

ORIGINAL

Post (now missing) from which a:

50" Burnt Fir bears S87W 192 lks.; now 50" rotted, burnt, 15 ft.  
high stub, original scribe S and more recent knife scribes  
BT.

RESTORED


Set 1 $\frac{1}{2}$ " x 36" galvanized iron pipe with 3" bronze cap marked "OREGON STATE  
BOARD OF FORESTRY 1/4 S15 S22 1963 RS359", and from which a:

34" Fir bears N32W 21.6 ft.; scribed  $\frac{1}{4}$  S15 BT RS359.  
24" Fir bears S46 $\frac{1}{2}$ W 29.7 ft.; scribed  $\frac{1}{4}$  S22 BT.

Set 4 x 4 x 72" white painted Cedar post 2.0 ft. South of corner pipe.  
Oregon State Forestry Department metal location poster on 14" Fir N79W  
5.8 ft.

Dated Nov. 14, 1963

Restored by

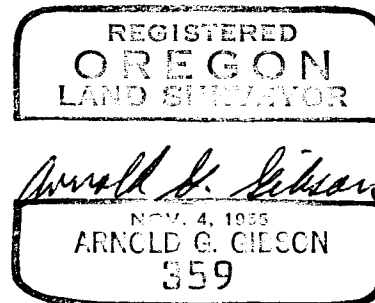

Present and witnessed by P. Lewellyn  
T. South