


COUNTY SURVEYORS FILE DATA
DO NOT REMOVE FROM OFFICE

FILED *L.L.*
RECEIVED

FEB 10 1964

COUNTY SURVEYOR
DOUGLAS COUNTY, ORE.

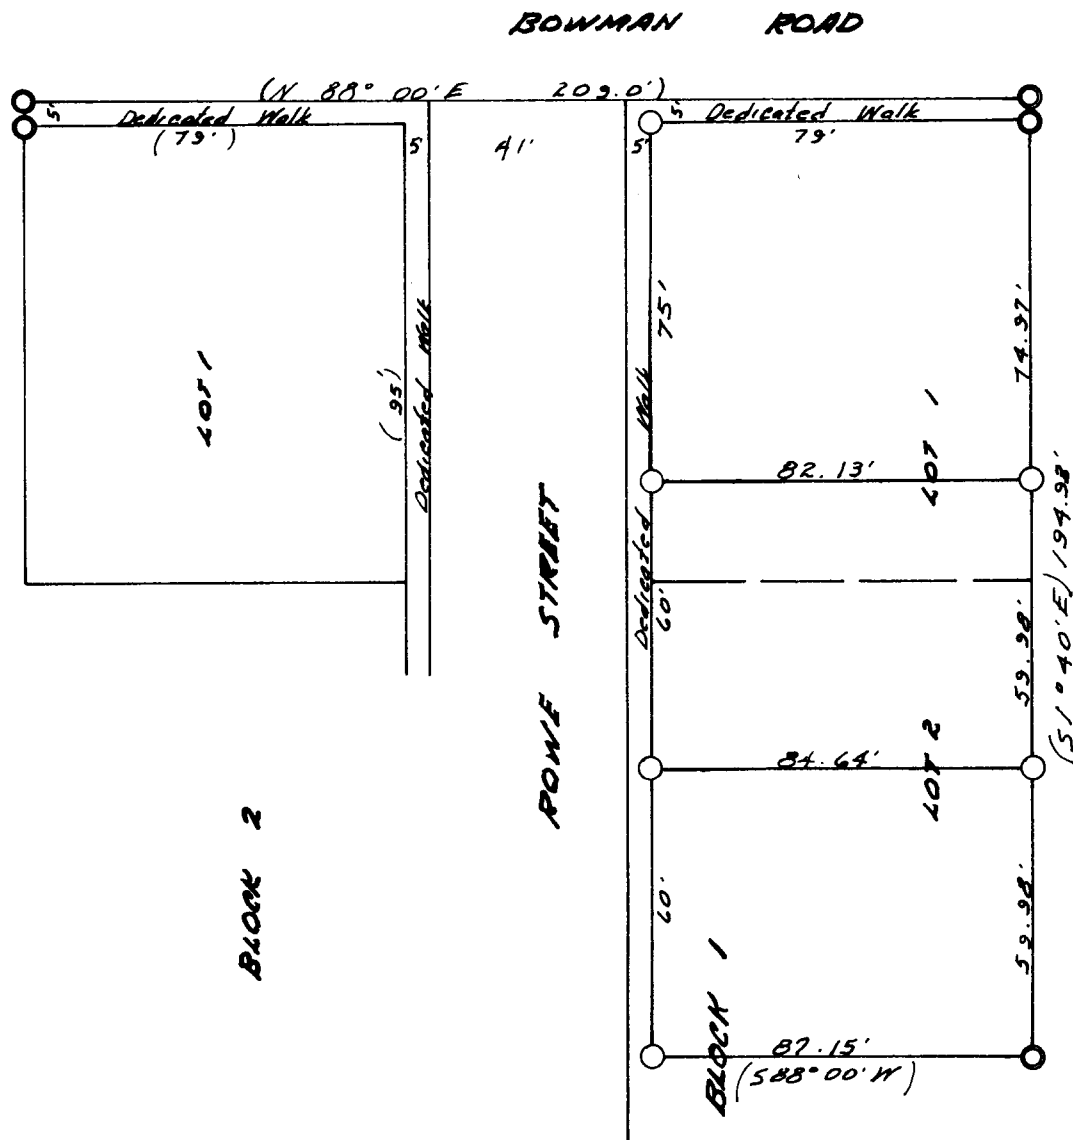

T. 22 S. R. 12 W. NE 1/4 Sec. 4

**SURVEY SUBDIVIDING LOTS 1 & 2, BLOCK 1,
ROWE ADDITION TO THE CITY OF
REEDSPORT, DOUGLAS COUNTY, OREGON**

for
ROBERT C. SUND

Scale: 1" = 40'
Corners found: ○
Corners set: ○
Record: ()

November 14, 1963

Bears for bearing: Plotted bearings

Warren D. Goodman

MAY 10 1964
WARREN D. GOODMAN

C. S. File No. 51/263-5