



BATE PLYWOOD COMPANY, INCORPORATED

January 14, 1964

County Engineer
Douglas County
Roseburg, Oregon

Dear Sir:

I wish to submit a corrected statement regarding section corners described in my letter of November 22, 1963.

During logging and slash burning the 1/4 corner common to Sections 7 and 18, Twp. 32 S., Range 3 W., W.M. was damaged in that the Incense Cedar bearing tree was knocked over and the face was burned out and the 48" Sugar Pine bearing tree is now a stump. The original 18" x 10" stone has been replaced at its original location with the 1/4 S scribe plainly visible on the north side.

I scribed 18" Douglas Fir tree S82 deg. 30' W - 9.3 feet from original stone.

I wish to refer to the 1/4 corner common to Section 18, Twp. 32 S., Range 3 W., and Section 13, Twp. 32 S., Range 4 W. During logging the original stone was lost. I found both Douglas Fir bearing trees with faces grown over. I chopped out both faces and exposed original scribing. I replaced original stone with iron pipe.

Very truly yours,

John Madding
John Madding, Professional Engineer

JM:hh
cc: Kenneth W. Jensen, B.L.M.

FILED
RECEIVED

JAN 15 1964

COUNTY SURVEYOR
DOUGLAS COUNTY, OREGON

Refer to Fred Darby
A.H.M.

P. O. Box 107
Merlin, Oregon
November 22, 1963

~~RECEIVED~~
NOV 26 1963

County Engineer
Douglas County
Roseburg, Oregon

DOUGLAS COUNTY ROAD DEPT.

Dear Sir:


I wish to refer to the 1/4 corner common to Sections 7 and 18, Twp 32 S., Range 3 W., W.M. During logging and slash burning the Incense Cedar bearing tree was knocked over and face burned out. The 48" Sugar Pine bearing tree is now a stump. The 18" x 10" stone is at its original location. To replace the Incense Cedar, I scribed 18" Douglas Fir stump N82 deg 30' W - 9.3' from original stone. ⊕

Referring to the 1/4 corner common to Section 18, Twp 32 S., Range 3 W., and Section 13, Twp 32 S., Range 4 W. Area of this corner was logged and original stone lost. I found both Fir bearing trees, which are now stumps, with faces grown over. I chopped out both faces and exposed original scribing. I replaced original stone with iron pipe. ⊕

Very truly yours,

John Madding
John Madding, Professional Engineer

JM:hh
cc: Kenneth W. Jensen, B.L.M.

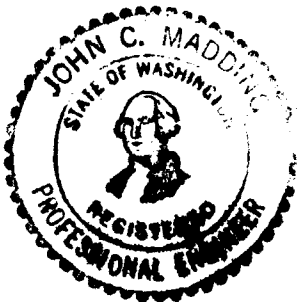

SEE LETTER of Jan. 14, 1964

FILED *L.L.*
RECEIVED

NOV 26 1963

COUNTY SURVEYOR
DOUGLAS COUNTY, ORE.

U. S. File No. 51/270

FILED *L.L.*
RECEIVED

CORNER RESTORATION

NOV 26 1963

Sec. 18 Twp. 32S. R3W W.M.

COUNTY SURVEYOR

DOUGLAS COUNTY, CORE

RECEIVED

~~NOV 26 1963~~

48' S.P. 158' @ N50°W (ORIGINAL)

~~DOUGLAS COUNTY ROAD DEPT.~~

Replaced ● original 18" stone

18" D.F. 93' @ N82½°W (BATE SCRIBED ¼ S)


10" I.C. 106' @ S30°W (BURNED OUT ORIGINAL)

48' D.F. in 14.0' @ N81°W

Set 2" pipe ●

18" D. Fir 262' @ S85°E

18

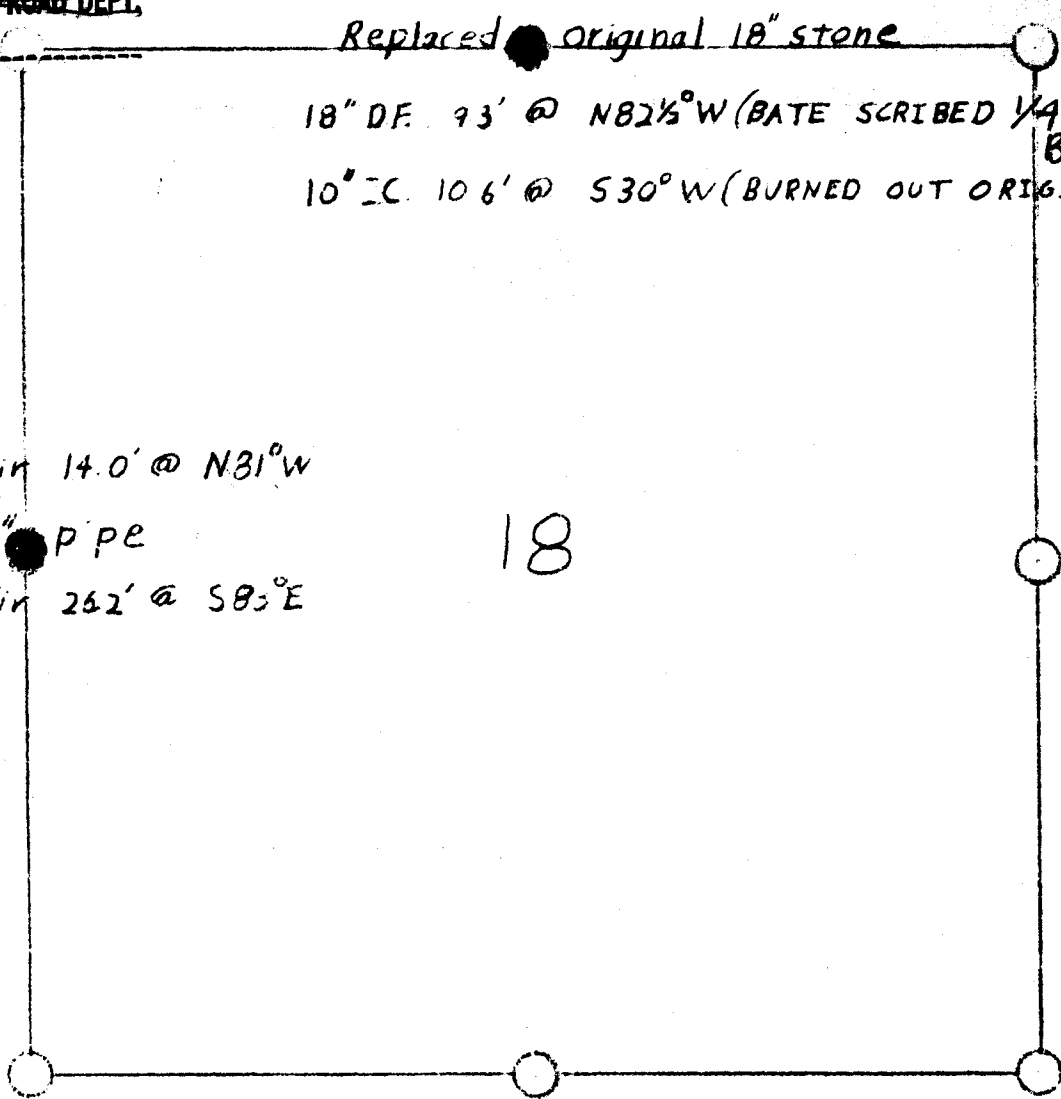

Datum

West ¼ Corner B.T.'s
have been restored by
a previous Survey.

One North ¼ Corner
BT replaced as shown.



Legend

● Restored corner

by Bate Plywood Co.