


PARCEL in LOT 1 · BLOCK 2 · PLAT "A" SUTHERLIN LAND & WATER CO.
SUTHERLIN, OREGON

MABEL J. AABY SUB.							
16	15	14	13	12	11	10	9

COPIED SURVEYING ...
DO NOT REMOVE FROM ORIGINAL

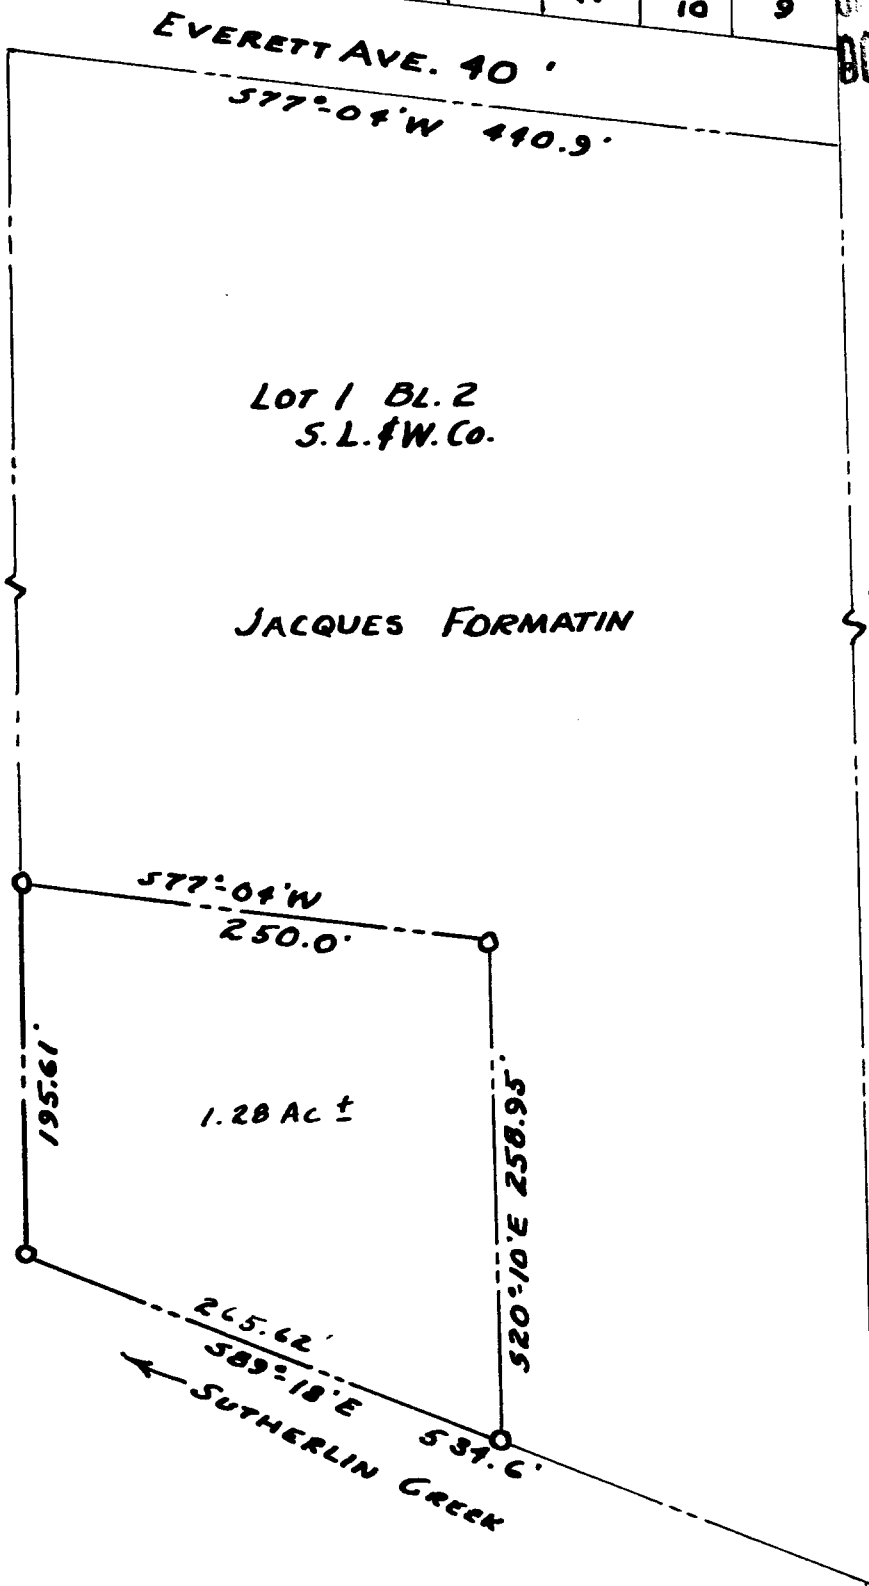

LOT 2 BL. 2
S.L. & W. CO.

WAITE ST. 60 FT.
N20°-10' W 745.61'


521°-49' E 896.91'

JACQUES FORMATIN

1.28 AC ±

FILED L.L.
RECEIVED

JAN 8 1967
COUNTY SURVEYOR
DOUGLAS COUNTY, ORE.

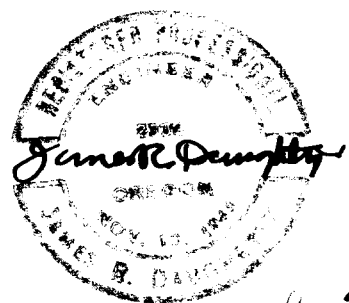

SCALE: 1" = 100'

JAN. 4, 1967

JAMES R. DAUGHERTY
CIVIL-SANITARY ENGINEER
WINSTON, OREGON