

Roseburg Timber Service

ROAD ENGINEERING & LAND SURVEYING
1717 S.W. McLain
ROSEBURG, OREGON

February 17, 1964

Douglas County Surveyor
Douglas County Courthouse
Roseburg, Oregon


CORNER RENEWAL:

NORTHEAST CORNER OF THE ROBERT PHIPP S D.L.C. 42
in SECTION 34, T28S, R6W, W.M.:

I found a $\frac{1}{2}$ " iron rod at a fence corner, from which a:

36" white oak, original BT with old scribes "C 4" visible on the south side and a very old face (now mostly rotted out) on the north side, bears S12°E, 47.8 feet.

10" white oak, I scribed "DLC 42 T28S R6W", bears N2°E, 77.2 feet.

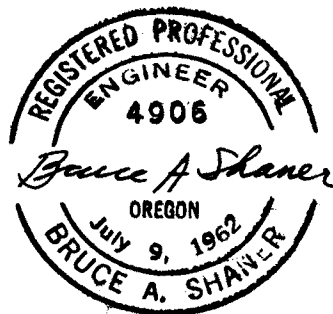

FILED
RECEIVED

FEB 13 1964

COUNTY SURVEYOR
DOUGLAS COUNTY, ORE.

⊕ ✓

C. S. File No. 51/281-1