


0.85 ACRES

**COUNTY SURVEYORS FILE DATA
DO NOT REMOVE FROM RECORD**

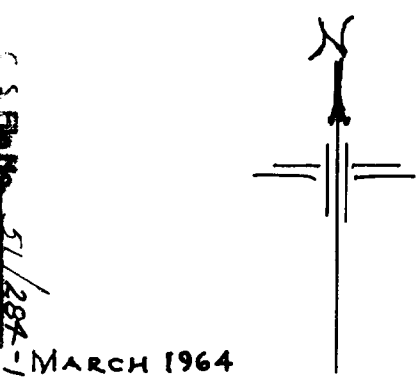

FILED *LL*
RECEIVED

SCALE: 1 IN. = 30 FT.

MAR 20 1964

FIELD SURVEY & PLAT FOR

THE LAVADOUR COMMUNITY CLUB

DAYS CREEK, OREGON

COUNTY SURVEYOR
DOUGLAS COUNTY, ORE.

**NE 1/4 NE 1/4 SEC. 30 TWP. 30S RGE. 3W W.M.
DOUGLAS COUNTY, OREGON**

● DENOTES SETTING OF 3/4" IRON PIPE

MARCH 1964

MARTIN ENGINEERING SERVICE ~ MYRTLE CREEK, ORE.

C.S. FILE NO. 51/287-1