


T. 25-5 S. 20C. 20C

LOT 13 · BK. 2 · PLAT · C · SUTHERLIN LAND & WATER CO. DOUGLAS CO. OREGON

William J. Cranford

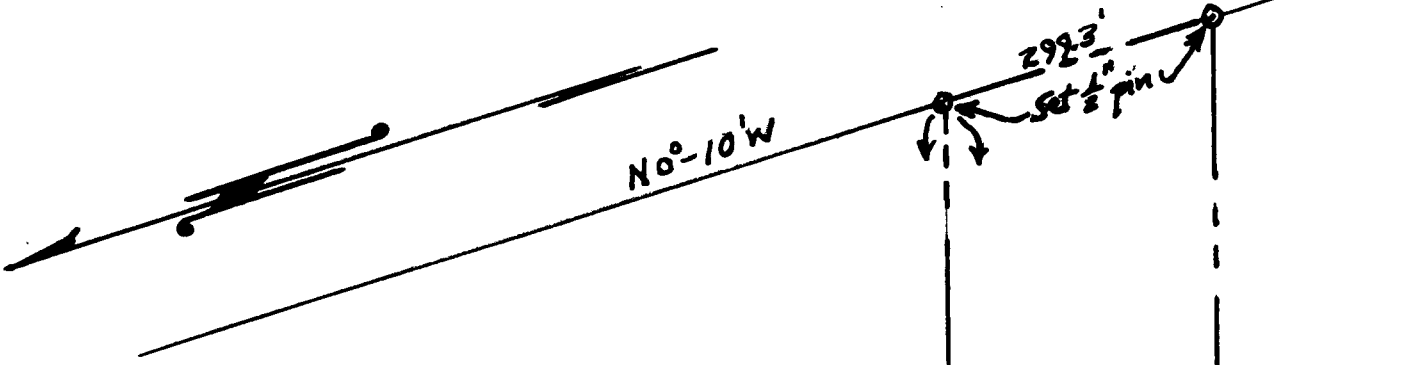

COUNTY SURVEYORS FILE DATA  
DO NOT REMOVE FROM OFFICE

FILED *LL*  
RECEIVED

JUN 26 1964


COUNTY SURVEYOR  
DOUGLAS COUNTY, ORE.

Set 1/2 pin

N 73°-56'W 1487.59'


808.5'

573°-56'E 1571.26'

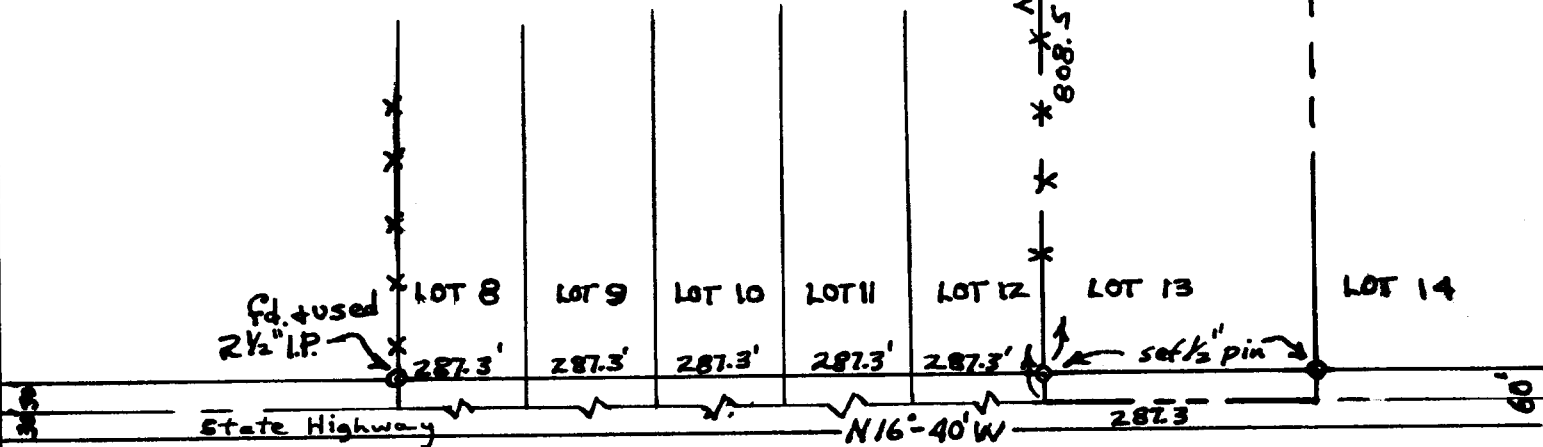

April 13, 1964  
Scale 1"=200'

JAMES R. DAUGHERTY  
CIVIL-SANITARY ENGINEER  
WINSTON, OREGON

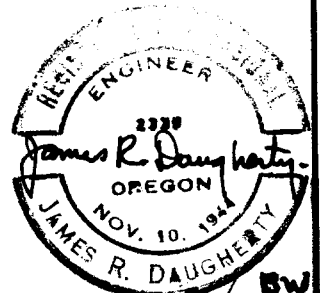

U. S. File No. 51/2961 P