


Prepared for :
 PAUL B. HULT LBR Co.
 showing
 Survey in Sec. 9-10-15-16-21-22 T29S R4W
 John H. Markham, Jr. June 1964
 Scale 1" = 1000'

FILE *LL*
 RECEIVED
 JUN 20 1964
 COUNTY SURVEYOR
 ILLINOIS

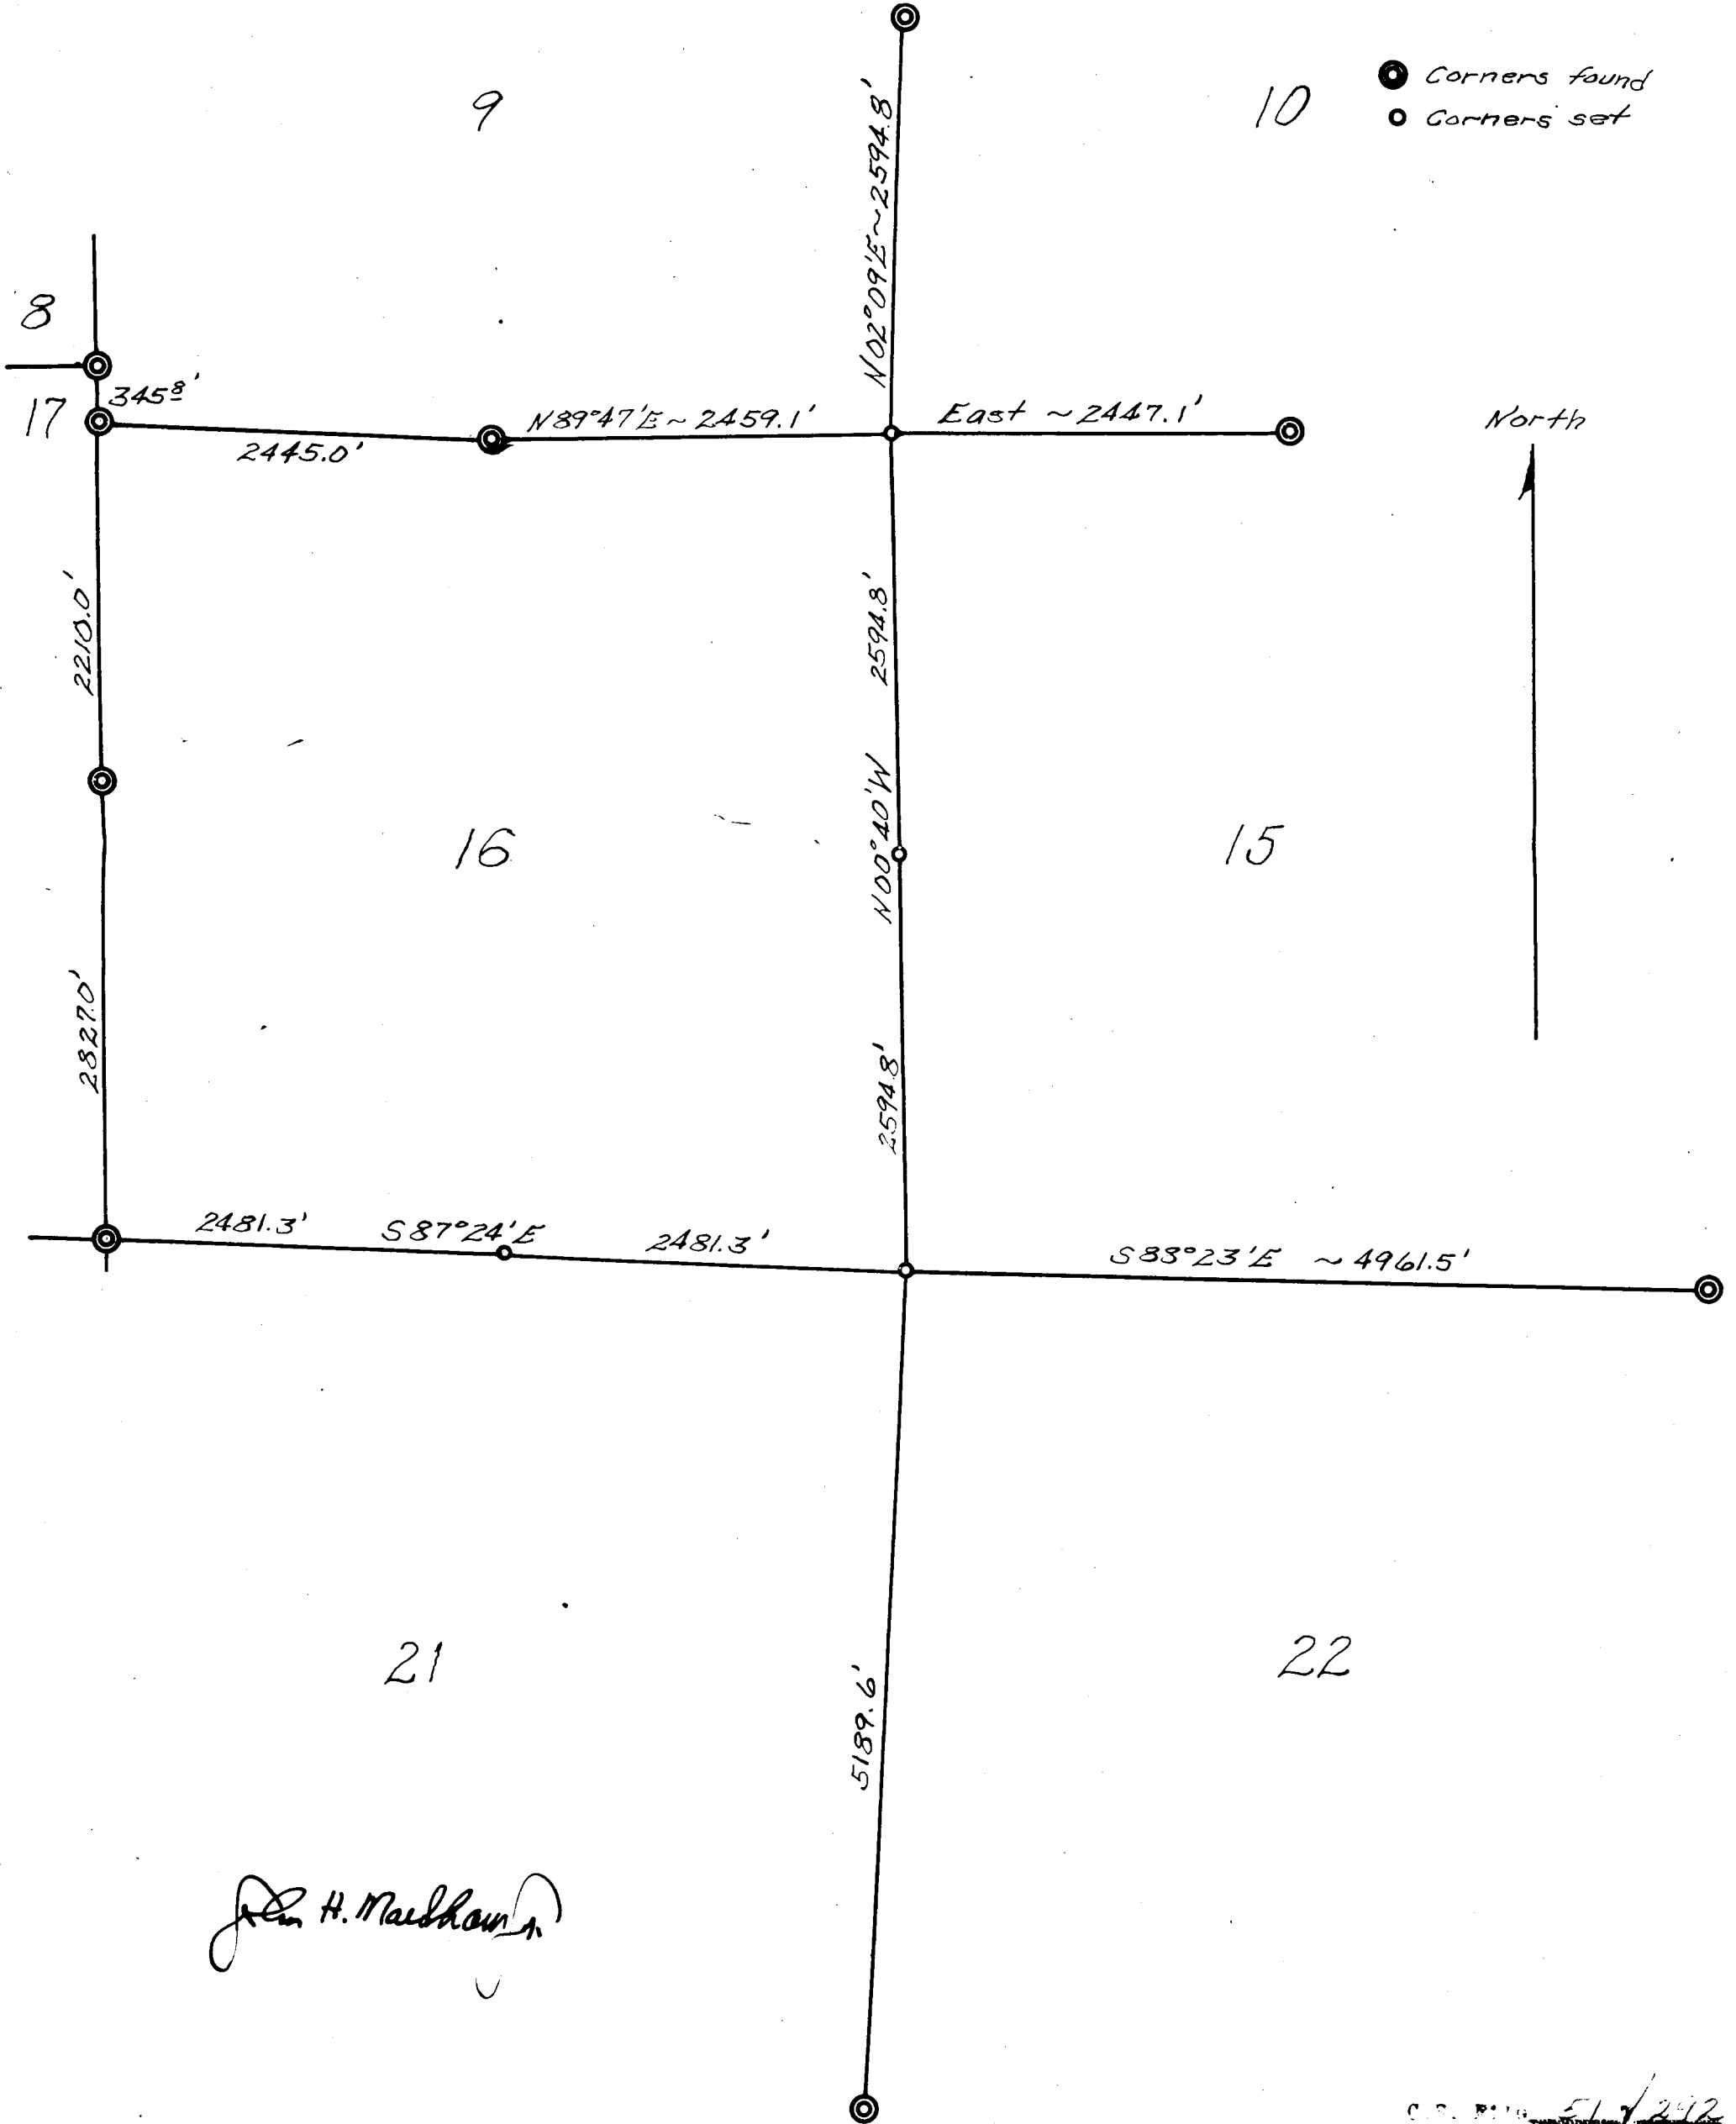

John H. Markham, Jr.

C.S. FILE 517242
 Vol. FILE M28-25