


REFERENCE DATA for STONE MONUMENT on BROAD STREET  
LOT 57 EDENBOWER ORCHARD TRACTS

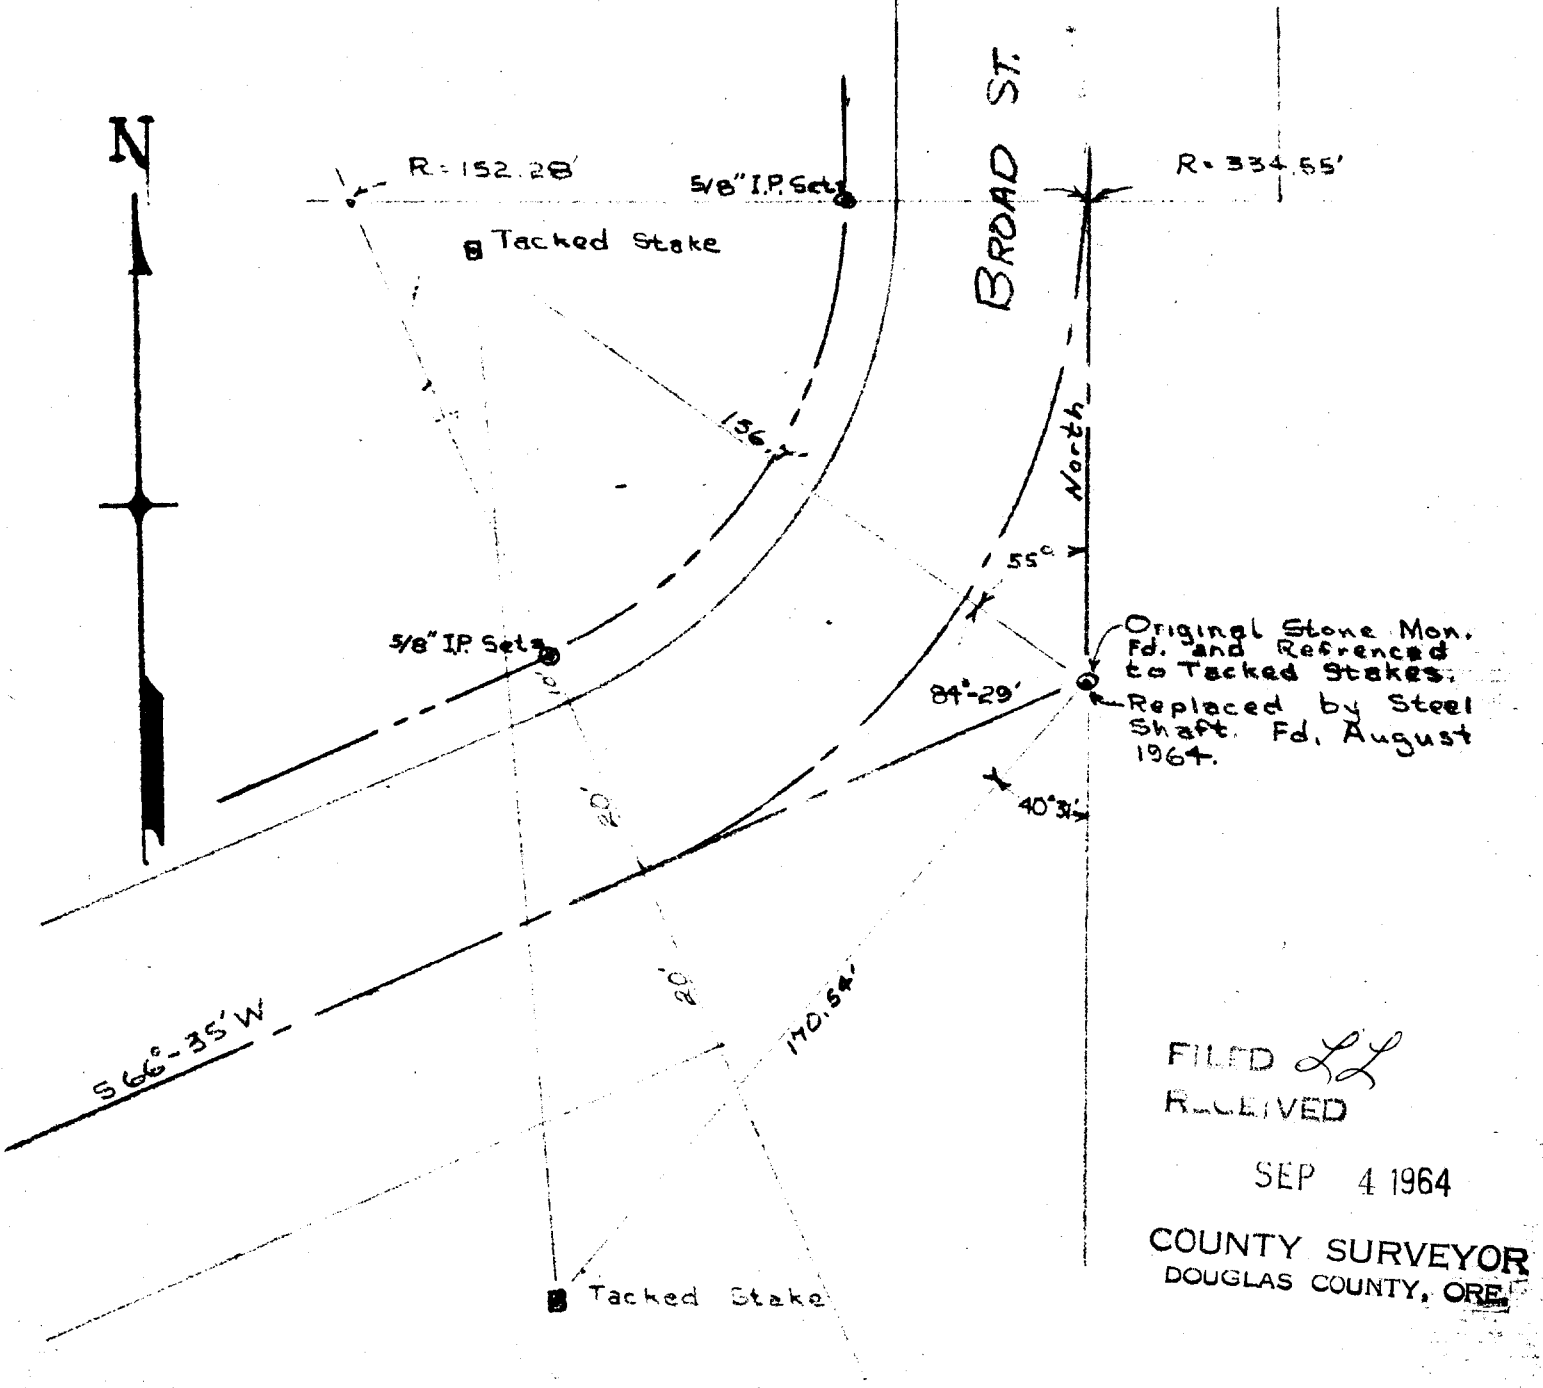

Original Stone Mon. Fd. and Referenced to Tacked Stakes. Replaced by Steel Shaft. Fd. August 1964.

FILED *LL*  
RECEIVED  
SEP 4 1964  
COUNTY SURVEYOR  
DOUGLAS COUNTY, ORE.

NOTE: STATE HIGHWAY REFERENCE DATA USED TO TACKED STAKES  
SEE SURVEY OF LOTS 51 AND 57 EDENBOWER ORCHARD TRACTS AUGUST 8, 1964.


SCALE: 1" = 40'

August 8, 1964

U.S. File 51/298

Map File M28-56

**JAMES R. DAUGHERY**  
CIVIL-SANITARY ENGINEER  
WINSTON, OREGON

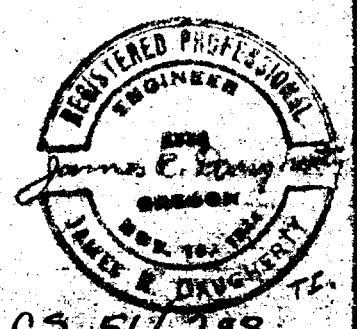

CS 51/298