

# ROLLING HILLS MOTEL in LOT 4 - DIXONS ADDITION

Douglas County  
Oregon

George Hestakis  
Parcel



FILED  
RECEIVED

*LL*

COUNTY SURVEYORS FILE DATA  
DO NOT REMOVE FROM OFFICE

SEP 4 1964

COUNTY SURVEYOR  
DOUGLAS COUNTY, ORE.

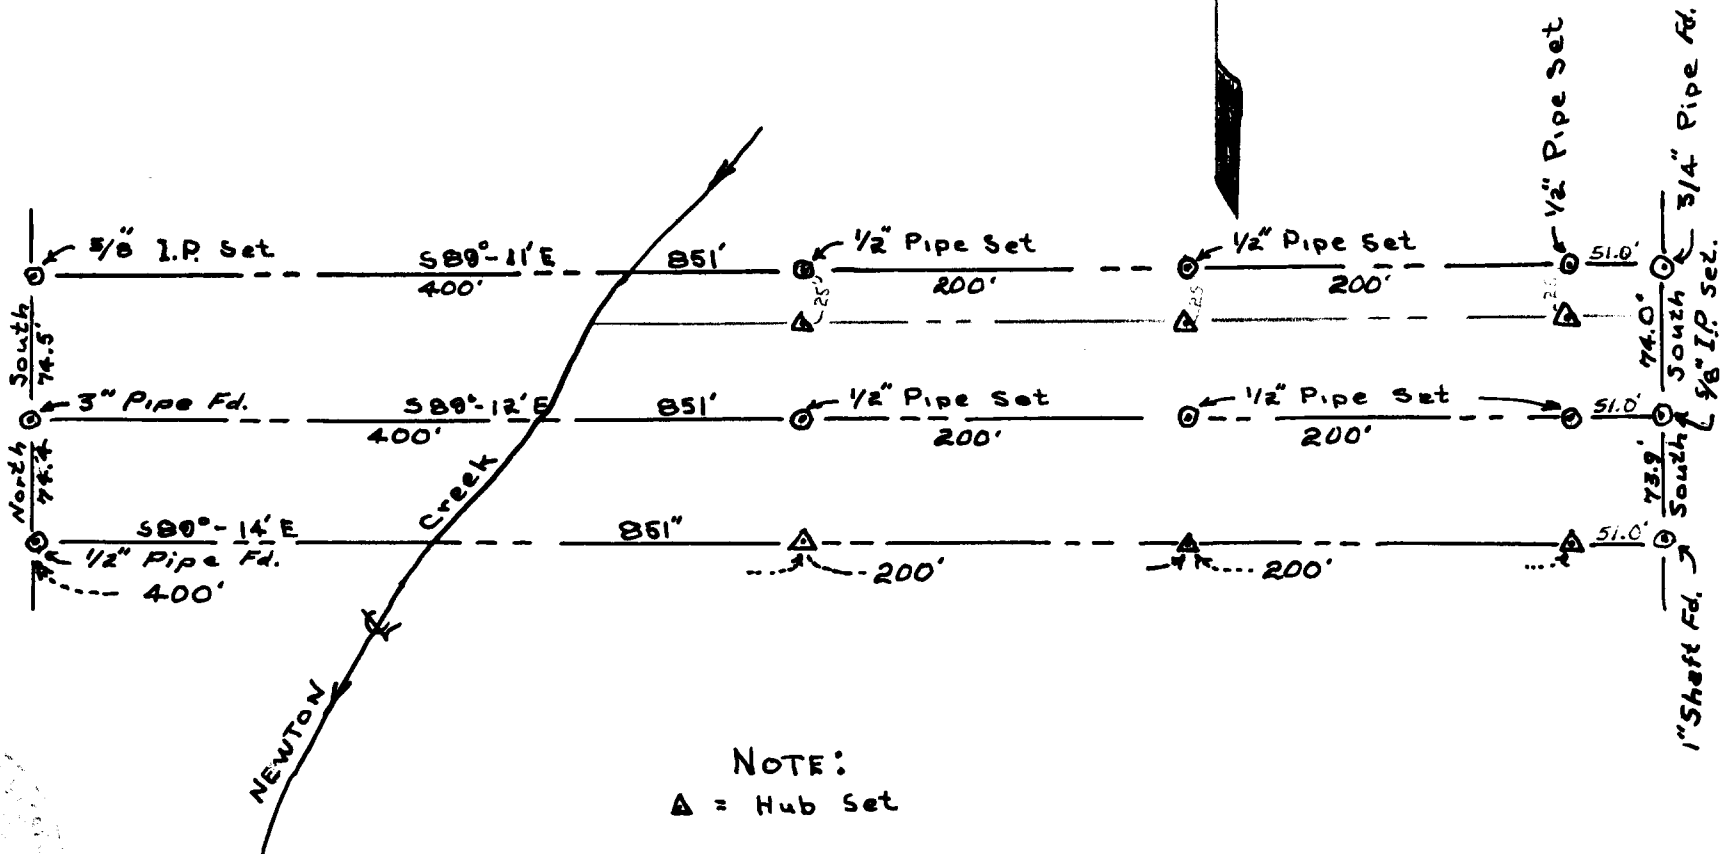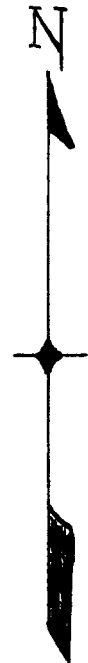

NOTE:  
△ = Hub Set

Scale: 1" = 100'  
August 26, 1964

PLATTED BY  
JAMES R. BERRY

*James R. Berry*  
Surveyor

51/299-4